C.S. # 857

Hardcopy 14-5 # 24

also see notes in file

F. B. 30-14

14 #857 FB #30

T 14 S R 5 W C.S. 169 Con.

Set on pt .10 W of center of sec 33 which is 1¼" shaft B.S. on pt .10 W of ¾" P

1.717

90° 10' L

4.633 - .10

Back to beg.

0° 28' L

21.565 N 0° 27' W

Tot ang 90° 06' L

15.10 to ¼" pipe

4.633

1¼" pipe

6 cor. pos N 47° 30' W .41

Hub bearing Sch N 61° 43' E about 6ch
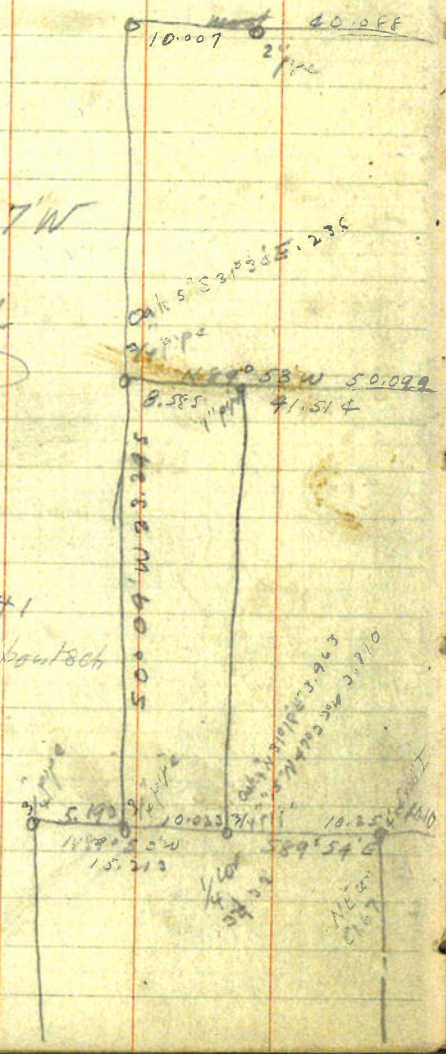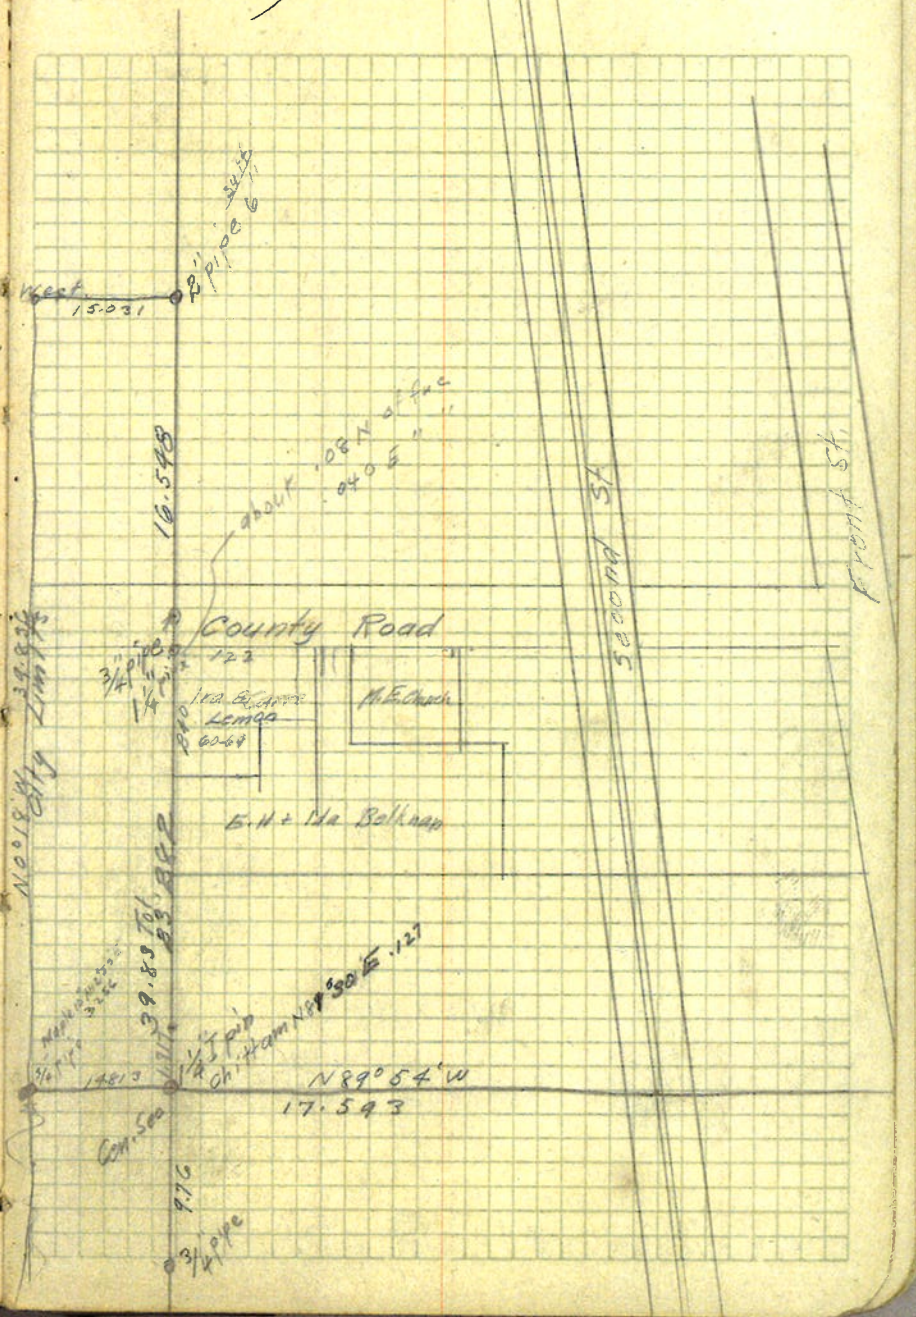
For Kay