860

BLOCK 4

Job's ADDITION

CITY OF Corvallis

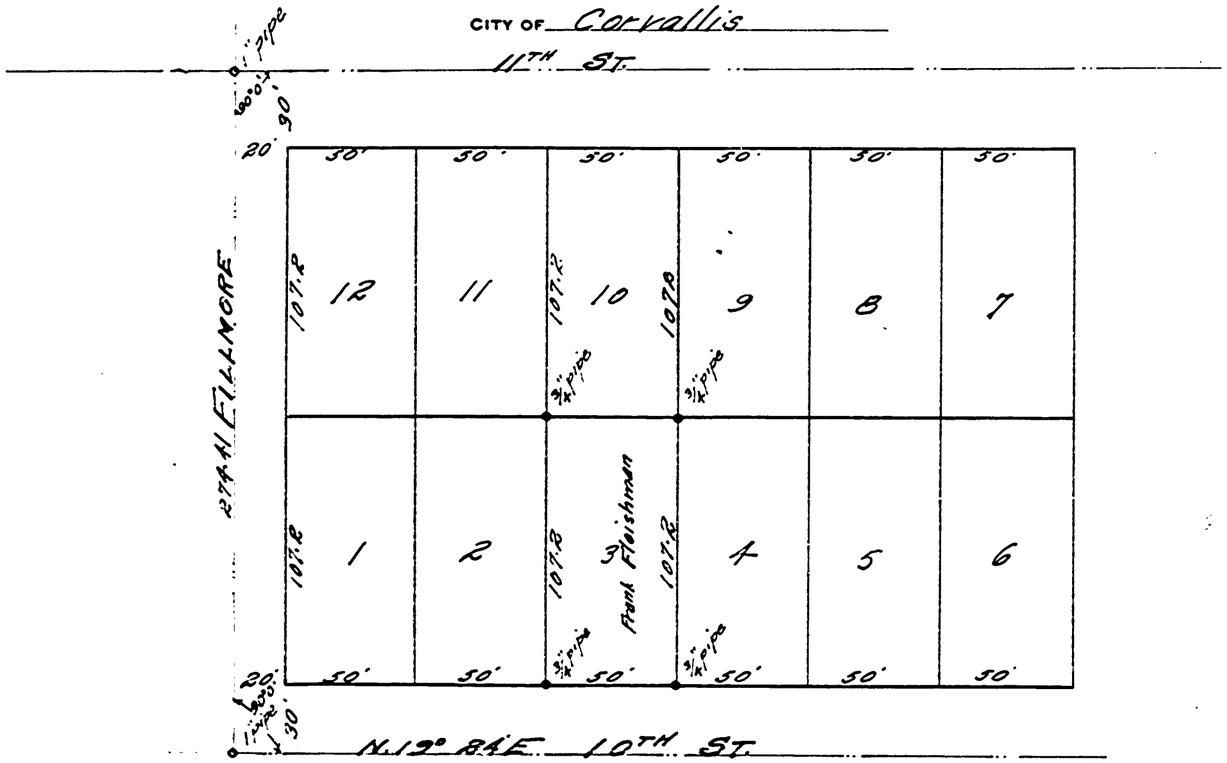

61

BLOCK 360

ADDITION

CITY OF

 

61