C.S. # 862

Hardcopy 13-5 #17

also see notes in file

F. B. 30-41

21

#862

FB#30

Survey CS 245 Cont.

4.977
4.267
4.085
Δ
1.712
A Δ
5.013
B Δ
4.646
5.000
2.002
2.982
4.959
3.013
Δ
2.800
5.004
Δ
2.169
+.026
Δ

15.041
13.329
1.712

Set .010 S

Set .013 S
40.109
39.634
.475

40.109
2.522
42.631
39.634
2.997

39.634
40.109
.475

20.022
2.522
5.832
5.576
3.334

39.634
+.910
+.498 2" pipe .026 S of A line

Correct 0°02'S

h.i. +.024 N of I

Back to B - F.S. on A line E

89° 49' L

0° 09' L

correct 0°05'E

0° 09' R

89° 51' R

offset .013W

set .015 E

13
T 13-5 R.5. Irwin tract

B39-169 W½ of S.E.¼ of SE¼
and 15ᵃ off E side of S½ of SE¼
of NE¼ of Sec. 36 T 13-5

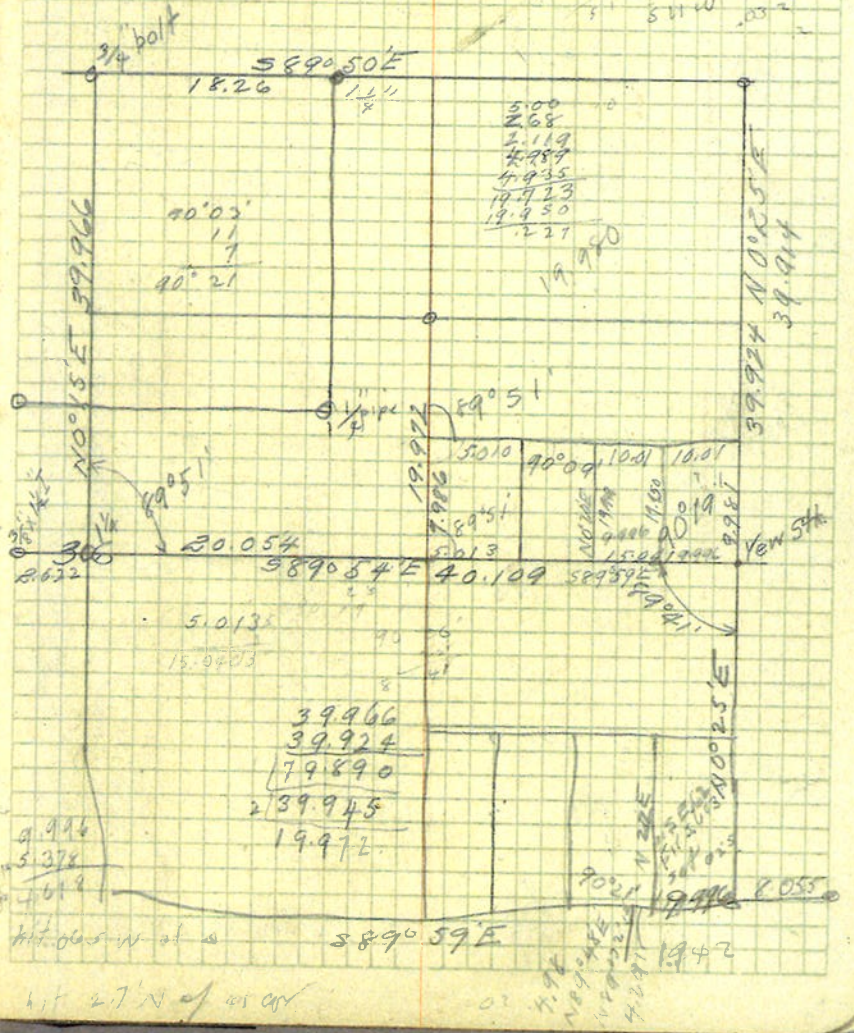

42

5.010 + offset

5.000

0° 35' L

4.125

△

90° 35' R Tot 90° .042 N

2.370

89° 22' R? Tot 0° 38' R ✓

4.590

1.315

5.905

△

90° 38' L offset 0655

2.393

5.010
5.000
4.125
5.905
20.040

4125
6102
8250
41250
.0420

5.000
4.125
4.590
13.715
15.030
1.315
.0655
.042
.023

2.37
0.23
2.393

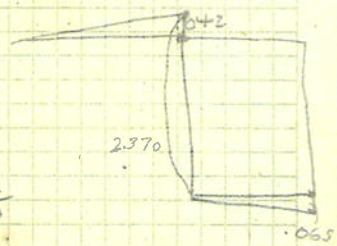

5.905
5.9
5.9
.0649