C.S. # 863

Hardcopy 14-6 # 19

also see notes in file

F. B. 30-43

43

#863 June 23, 1923 FB#30 34-T14-6

For Clifford S. Weaver

Survey 307 Cont.

Set on RR spike 1'W & Rd Fs on

S17°42'W at 2.55 65° 50' R

69° 17' R

328.02'
4.970 S86° 59' W

3° 48' L

138.07
2.092

½" pipe 17° 17' R

Δ 50'
.757

Δ 120'
1.515 1" iron rod at Hang set ½" pipe

Δ 50'
.757 E

Δ set 1" iron for SE cor

from which Maple 24" S65° E .22

Back to spike & Rd & RR Fs S17°42'E

25° 41' R

440'
-11'45' .650 .066

41° 36' R 1" rod

140.2'
2.124 2541 5.55

1" rod

Δ 65°
.985 S17°42'W +.39 25ft 1½ rod

Set in NW circ lot B.S. NE cor

67° 19' L
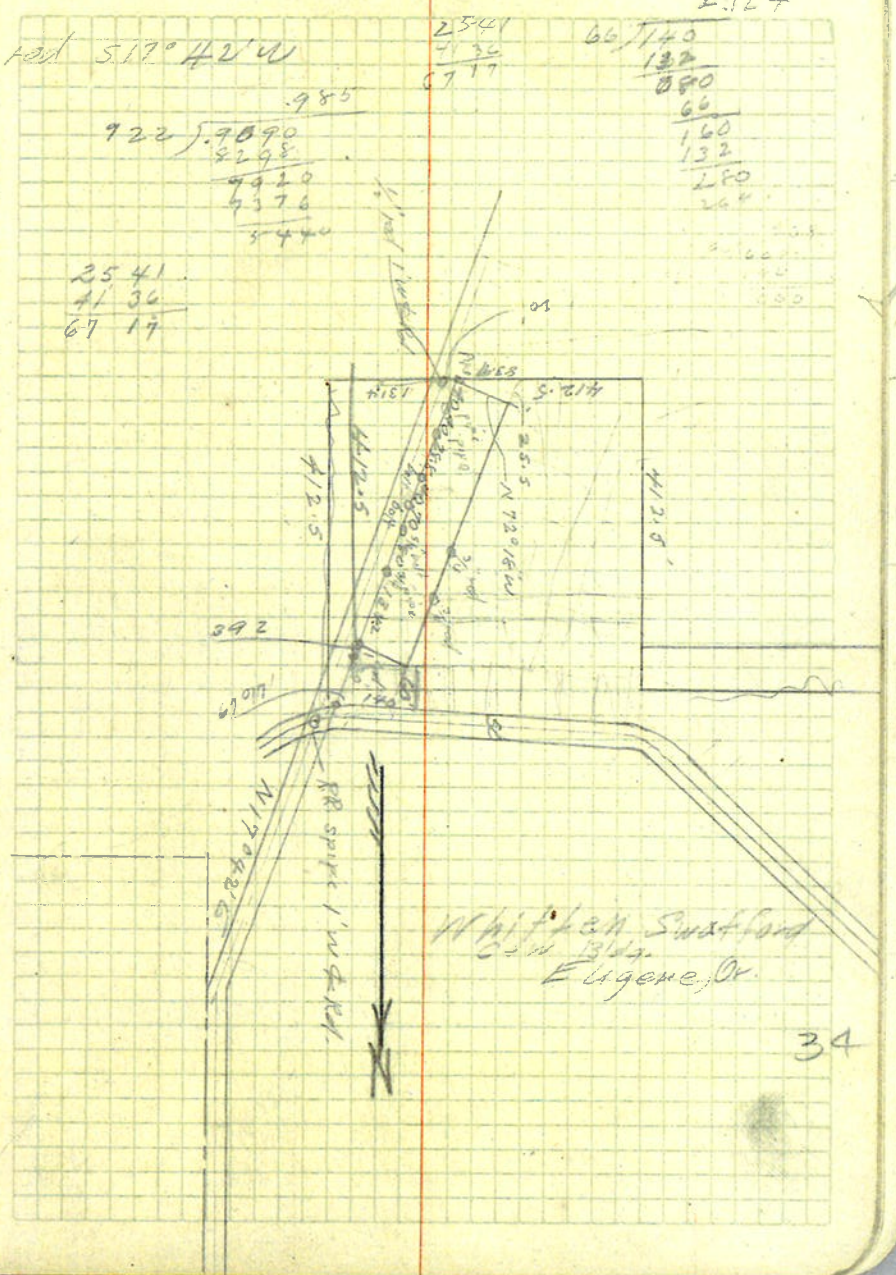
650'
.985 set 1" rod.