C.S. # 865

Hardcopy 12-6 #1

also see notes in file

F. B. 33-37

37
865

C.S. #37 Continued
Copy

FB #33

Beginning at a stone the
N. W. cor. of Norris P. Newton Cl. 44
T 12-6
N 0° 54' E
correction E. 6½'
(N 1° 00½' E)

1			2.761	2764 to c line 4 to & near rail S 56°27'
				From RR to transit line
2			13,657	.082 E to fence
			+	+.056 to fence corner
			+ E .031	
				.013 E
				.044 E
				.026 E
				.070 E
				.027 E
				.097 E
3			7,254	E .044
			+9,250	
			E .061	at ⊙
4			13,690	E .070
		+1°	8.000	
6		+1°30'	6.723	
			-.005	
			.097	

Striking W. of cor.
N.E. cor. St. Clair Cl.
Orig stone 12"X12"X?

Date: July 7, 1923
Party: W.C. Galloway
H.E. Wilbert
B.K. Taylor

For Godfrey Schimpf

.00186 = 6½'
52,076) .097

.013 E
.013 E
.044 E
.026 E
.070 E
.027 E
.097 E

T 12-6

57°21
57°06
15' correct

R.R. Brg.
S 57°21' W
56°27'
54'

2.761
13.657
16.418
.056
16.474
3.350
13.134

7.254
13.690
7.999
6.720
52.081
.005
52.076
16.500
35.576

52.076
16.722
68.798

38

	Int. ∠ 90°30'			
	N88°36'W correction N½'		16.000	
7	(N88°35½'W)	+2°15'	6.413	
8			8.168	
			+.057	
			N.005	
	Set ¾" pipe			
	Set ¾" x 1¼" I S 30'E .455			
			8.000	
9		+1°45'	5.946	
			8.000	
10		+3°15'	4.393	
	∠ of road		N .009	
	Set 1" pipe, Oak 16" S 8°15'E	.427 chs	−.248	
	" 12" S 62°45' W	.433 "		
	" 16" N 21°40' W	.22 "		
11	∠ Left 37'	+9°50'	4.328	offset .0469
12		+6°30'	5,040	offset .029 N
13		-1°30'	5.933	
14		-1°40'	5.275	
		+2°	3.063	
	Striking S. of cor.		.030	
	S.W. corner of Wm. Wyatt Cl. 48			
	Back to △8			
15	S 1°04'W correction W10'	-45'	8.024	
16	(S 1°14'W)	-1°10'	8.072	
			3.055	
17			W. 113	
			+.023	

offsets
.0469
.029N
.0175
.030 N
80.491 .019 N .00016 = ½

56.953
.248
56.705

16.097
6.408
8.168
30.673
8.000
5.944
8.000
4.336
56.953
4.264
5.008
5.931
5.273
3.061
80.490

80.490
56.705
23.785

.005
8.023
8.070
16.098
3.055
19.153
16.114
.083
35.950

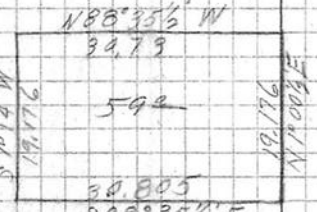

39

18				16.114	
				+.083	
				W.160	
	Set scythe blade			S. line of	+.088 for 380 ±
	Back to △17				
19	S 88° 35½' E			13.294	
			-3°40'	3.019	
20				7.013	
21				7.315	
				+.055	
	set stick				

19.153
16.114
.083
35.350

35.438
35.350
.088

.113
13.294
3.013
16.420
7.013
7.315
.056
30.804