C.S. # 866

See notes in file

F.B. 33-43

33

MINING

TRANSIT BOOK

363

43 Block 5 Monroe, Oregon
Copy

866

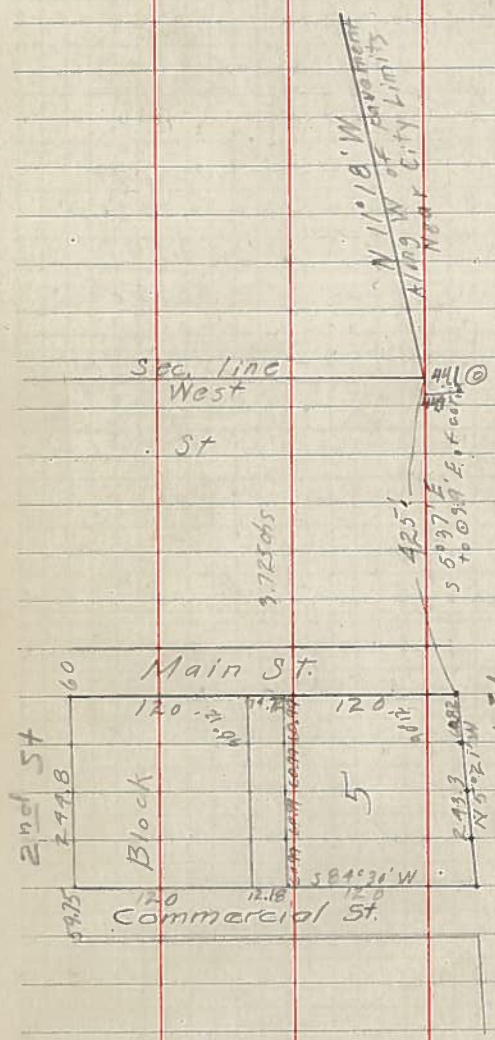

Date: August, 1923
W.C. Galloway