C.S. # 867

Hardcopy 11-5 #18

also see notes in file

F. B. 30-45

FIELD BOOK NO. 30
PAGE 45

45

T. 11 S. - R. 5 W. Cl. 48

Aug 22, 1925 C.S. 129 Con.

8/38

2.3

#867
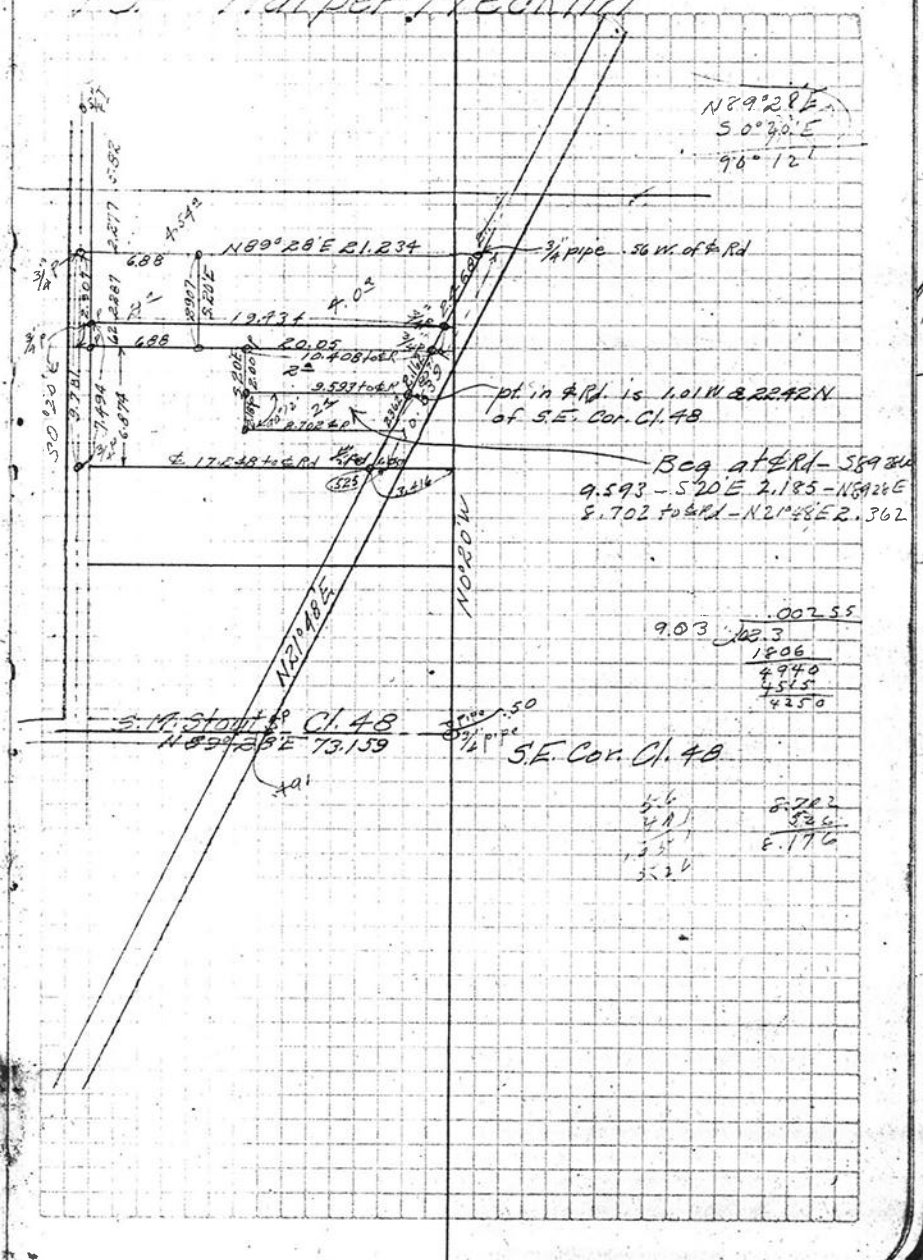
For Harper Meeklin