C.S. # 868

Hardcopy 11-6 # 16

also see notes in file

F. B. 33-44

44
868

CS #296 Copy FB #33

For Mrs. I. Bent

Date: Aug. 27, 1923 T 11-6

Party: W.C. Galloway
B.K. Taylor

East line etal. of Perman Henderson Cl. 50

T 11 S R 6 W

Beginning at 1" pipe the S.E. corner
W. Pearson Cl. 51

1	Thence S 89° 22' W	-10°30'	9.859 = 9.694	
	Rec's Set 3/4" galv. pipe			
	Oak stump 24" S 59° 38' E 4.69 cks, both blazes			
	" 12" S 56° 32' E 2.837 2.856	+6°40'		
	Fork of Branch of Fork " 6" S 7° 08' E 9.322 9.334			cen. of Fork
2	S 0° 38' E from cor. correction W 38'	+3°05'	6.406	W. .071
3			4.047	W. .116
4		+9°	2.529	
5			.447	W. .149
6		-1°30'	7.994	W. .238
7		+11°15'	4.176	W. .283
8		+2°25'	4.578	
			-.018	
	Rec's Striking E of cor.		.334	
	Int. cor. of Cl. 50			
	Set 1" pipe			
	Oak 12" N 82° E 1.16 cks			
	" 42" S 42° E 2.10 "			
	" 6" N 40° W .025			

.01112 = 38'
30.03) .3340

6.396
4.047
2.498
.447
7.991
4.096
25.475
4.573
30.048
.018
30.030

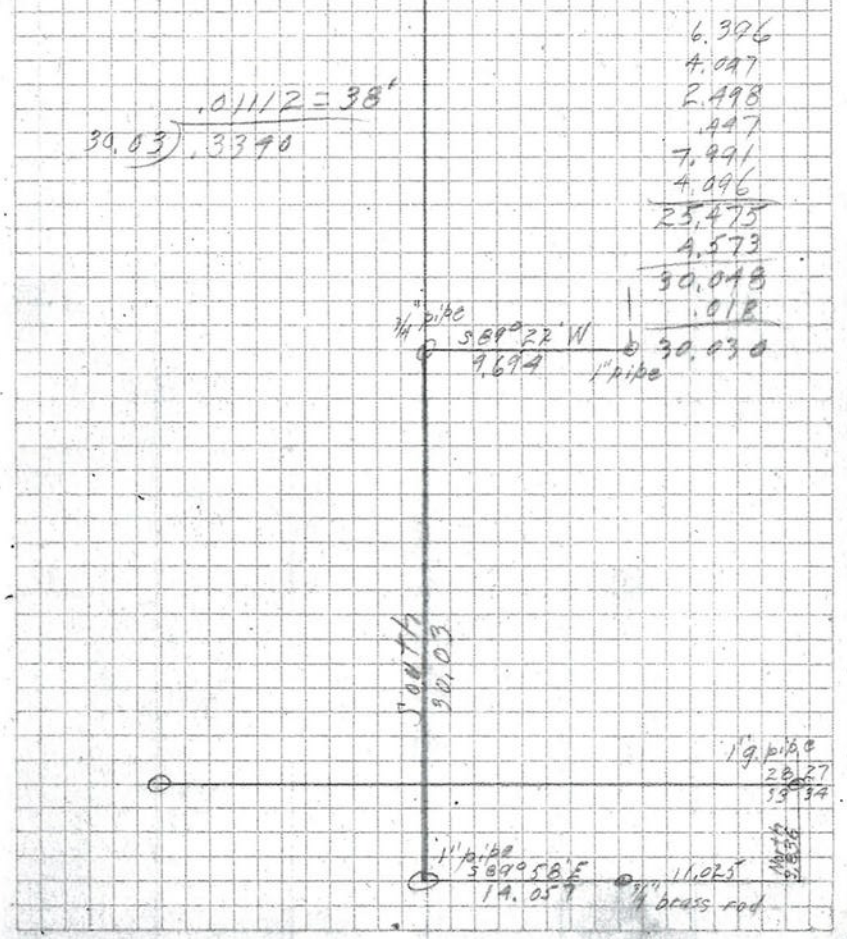

45

	N 89°22' E correction S 45'				
9	(S 89°58' E)	+7°35'	3.438	S. 037	
		+1°45'	8.000		
10		+7°20'	2.374		
			-.036		
	Striking N. of cor.		.146		
	Set ¾" brass rod pump valve				
	Oak 8" S 48° E .469 chs				
	" 6" S 28°55' W 7.58 "	Std.			
	" 12" S 42° W 7.15 "	"	"	Transit Tree makes it S 41°20' W	
	East				
11		-1°15'	4.040		
12	+ Left 1°52'	5°20'	3.354	offset N .109	
to 28|27 93|34	+ Left N 43°23' E 6°		5.053	offset N. 3.452	
	Set 1" galv. pipe				S 43°20 W
	Oak 12" N 0°15' W .909 chs				
	" stump 36" N 14°20' E 7.29 "	std.			
	" " 24" S 80°45' E. 7.10 "	"	"		10°25' slope
	" 5" S 10°20' W .790 "				
	" 10" N 53° W 2.89 "	"			

.146
.018
14.057) .164 (.011167 = 40'

.374
3.408
7.996
2.355
14.093
.036
14.057

14.093
4.039
3.341
3.652
25.125

offsets
.146 N
.109 N
3.452 N
.129 N correction
3.836 N

25.125
+ 4.057
11.068