871

BLOCK 24

COUNTY ADDITION
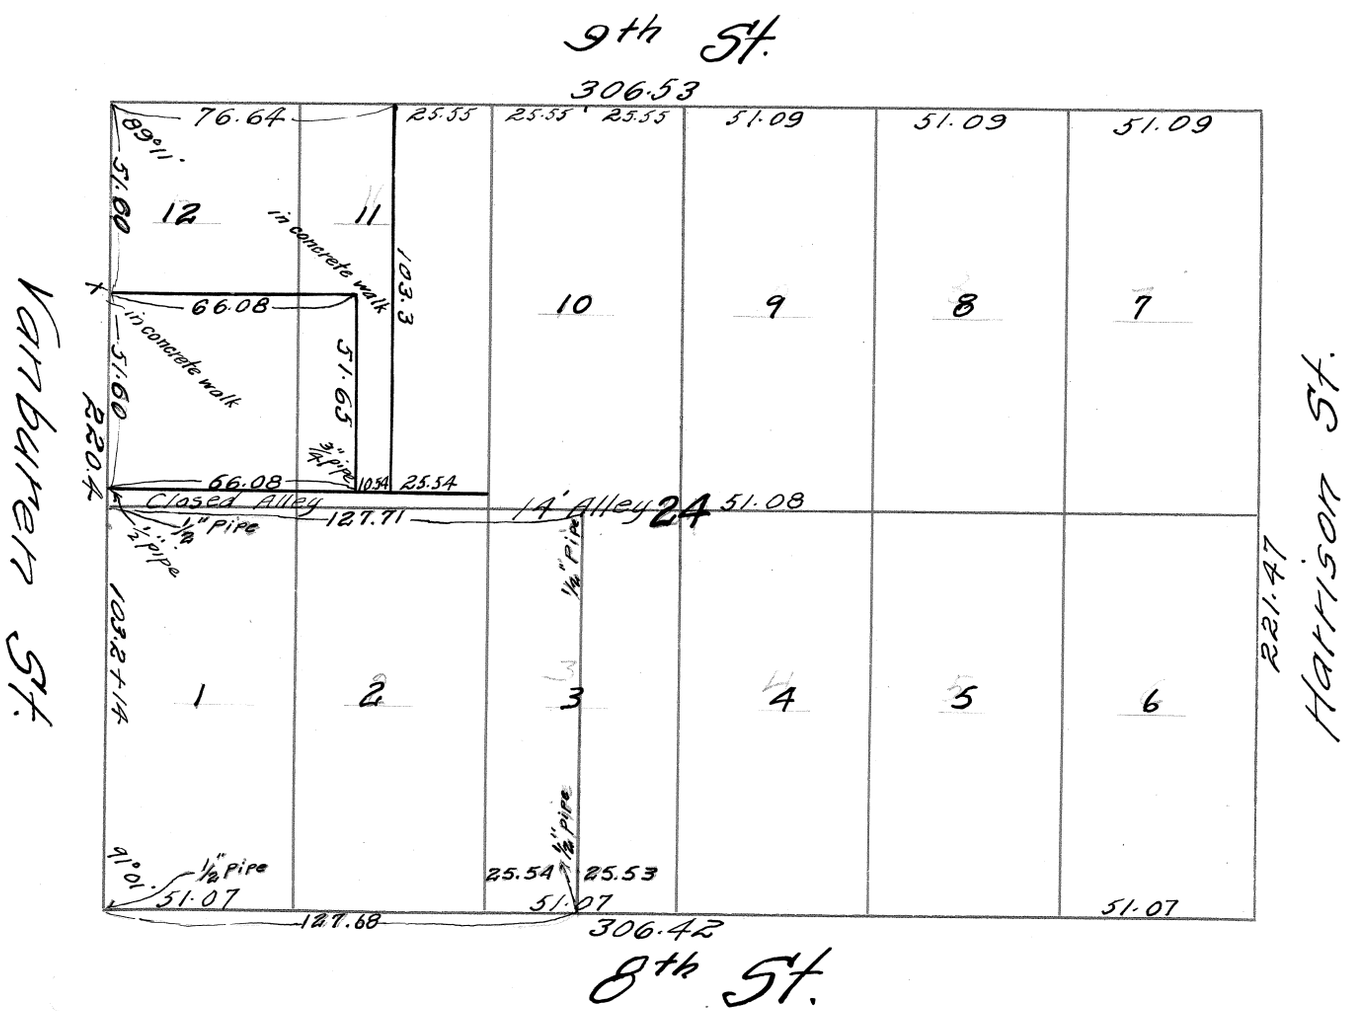
CITY OF Marysville