C.S. # 874

Hardcopy 13-5 # 19

also see notes in file

F. B. 30-51

5/ C.S. 241 Con

for Robt. Hughes #874

Began at NW Cor of Cl. 53 Heirs of Wm Miller Cl. 53

13.597	13.597	South	
1.799	1.797		
5.000	5.000		
5.000	5.000		
5.000	4.995		
5.000	4.992		
1.430	1.428		
.033	.033		
	36.842	95° 57'	
.300	.300	N84° 03'E	
		correct for 0° 26' = (N84° 29'E)	
	1/4 pipe	in fence line	
5.000	4.985		
4.820	4.815		
		0° 12' R	
5.000	4.995		
2.960	2.958		.0289
		0° 23' R	Tot 0° 35' R
5.000	4.995		
3.155	3.152		
3.250	3.234		
		1° 03' R	Tot 1° 38' R .116 S.
4.10	3.992		
		7° 36' R	Tot 9° 14' R .114 S.
5.008	4.995		
5.000	5.000		
2.363	2.363		S 86° 43' E
			correct 5 0° 07'
			= (S 86° 36' E)

FB# 30

T. 13 S. R 5 W

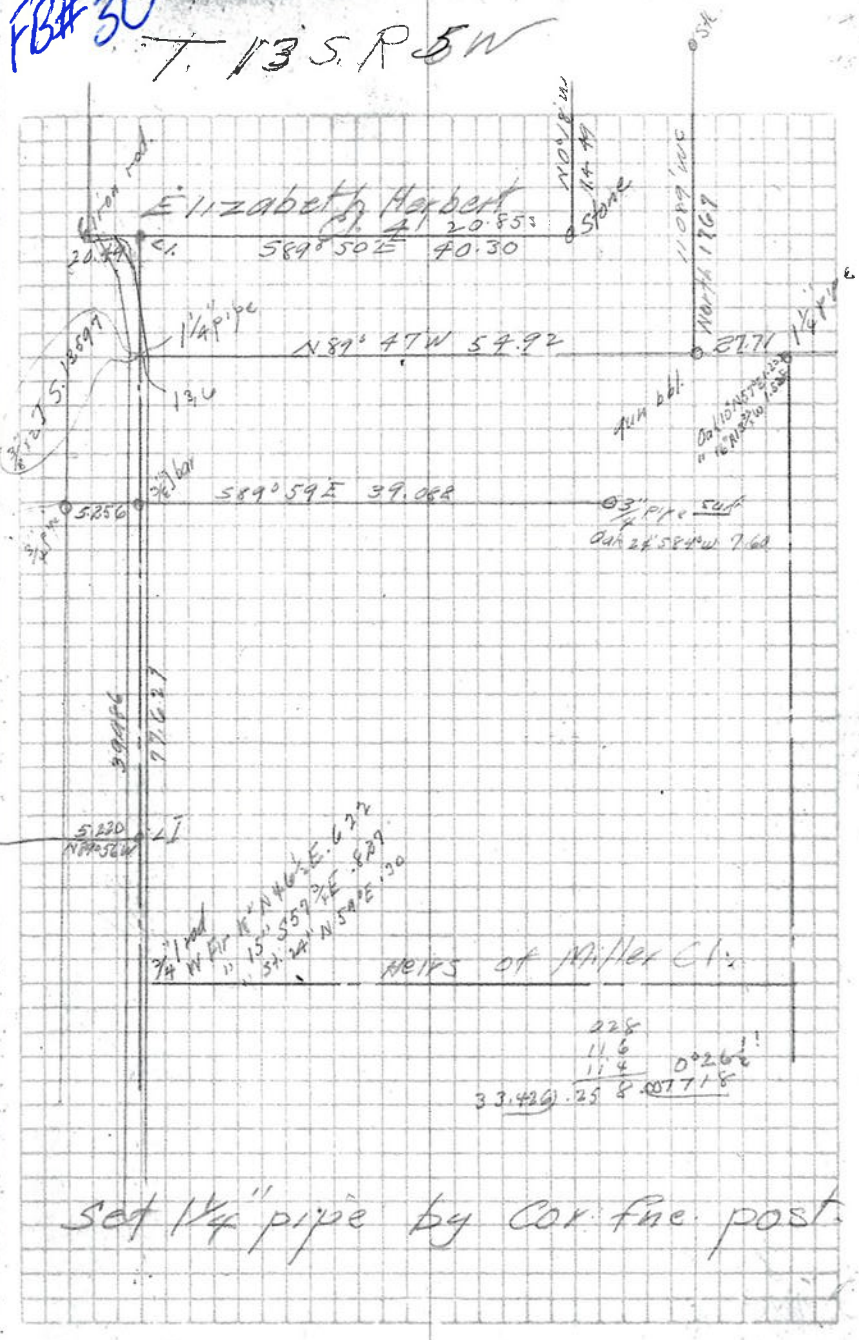

52

		0°18'R		Tot 9°32'R
5.000	5.000			
2.897	2.897			
△		0°10'L		Tot 9°22'R
5.000				
3.193				
△		103°22'L		1¼ pipe
5.000		N9°57'W		
3.570		correct 0°		=(N9°54½'W)
5.009				
△		0°04'R		
5.000				
5.000				
5.000				
5.000				
R.182 △		¼" pipe in fence line E+W		
.120				
△		79°34'L 1" rod		
3.429		N89°21'W		
		28°13'R correct 5°31½'		
		=(N89°58½'W)		
5.000				
1.454				
-1.756				
△		28°13'L		
5.000				
5.000				
2.690				

13.579
35.681
22.302
7.496
12.690

.0415
Tot 9°22'R
.0195
1¼ pipe
.026E
W

10.100
7.953
11.381
3.992
12.355
7.897
8.193
61.874

33.426
28.448

.0415
.0195
.0605

0°07'
28448).0605(.0021 09

0° 02½'
.002126
35.881).026

.464 ¾" rod

54.968

222N
4.140W

5.000	5.000	0			
5.000 +3° 30'	5.000 Tie	26.160			
3.480 +2° 30'	3.450				
5.000	4.995				
5.080 +4° 45'	4.963				
2.762	2.752				
Δ +1° 15'		16° 51' L		Tot. dist. =	52.003
5.000 +1° 0'	4.997				
4.426	4.420	9.417		2.730 S.	
Cl. Cor.	Beg. 16° 51' intang R. 303			9.513 W	
or	73° 37' L to line of beg				

2.730 S.
2.221 N = 0° 31 1/2'
55.432) .509 (.009182

to a 1¼" pipe in fnc line
.120 N. of E+W fnc.