C.S. # 875

Hardcopy 10-5 # 9

also see notes in file

F. B. 30-54

54 C.S. 34 con. #875 FB #30

School lot T-10-5 Sec. 24

Began at a 3/4" pipe in E Road as shown at A.
measured 39.440 N 50° 32' E along road
at -.020 and .30 S.E. of fac found 3/4" pipe.

3.27	Δ nail	in E road
5.00	4.987	
1.417	1.415	
-.070		

Set 1/4 x 1 1/4" iron
Set on 1 1/2" pipe at B. B.S. on 3/4" pipe at C - thus N 41° 22' E 9.84
+2.30 5.000 485 N S 35° 18' E

Δ in E of both roads
86° 05' R
to line up Sulphur Spring Road.

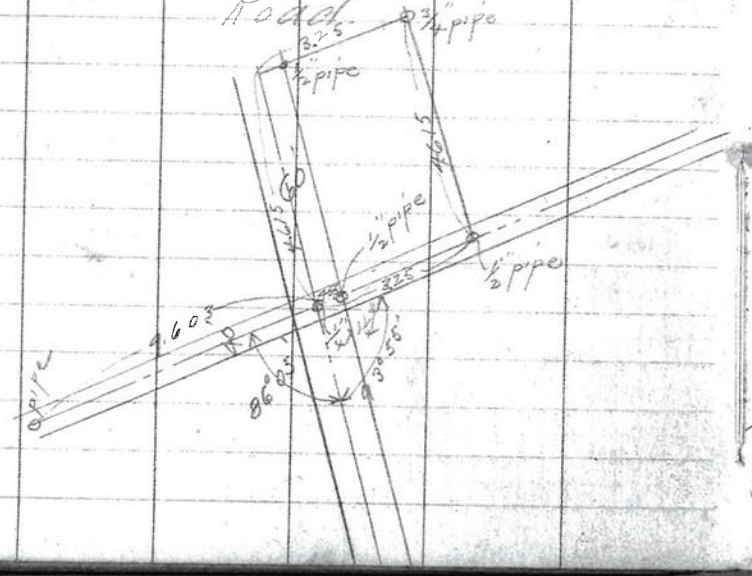
3/4" pipe
1/2" pipe
1/2" pipe
1/2" pipe
3/4" pipe
1/2" pipe
1" pipe
86° 05'
N 50° 32' E 460'
325'
460'
330'
330'
330