877

BLOCK 2

Chase's 3rd ADDITION

CITY OF Corvallis

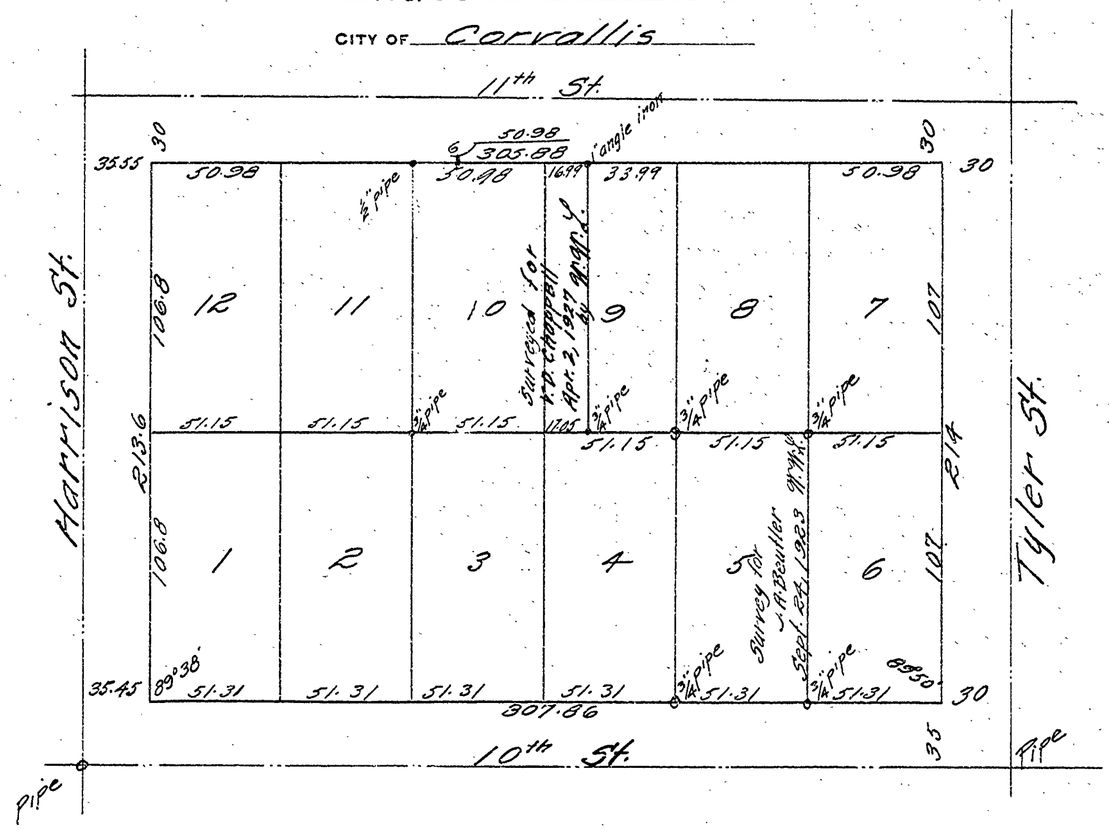

58.