Sec 2 T12SR5W

879

BLOCK 9

Town of Marysville ADDITION

CITY OF Corvallis

Surveyed Oct 15, 1923
Walter W. Larsen
Dep. Co. Sur
Ch. Sam. Wood

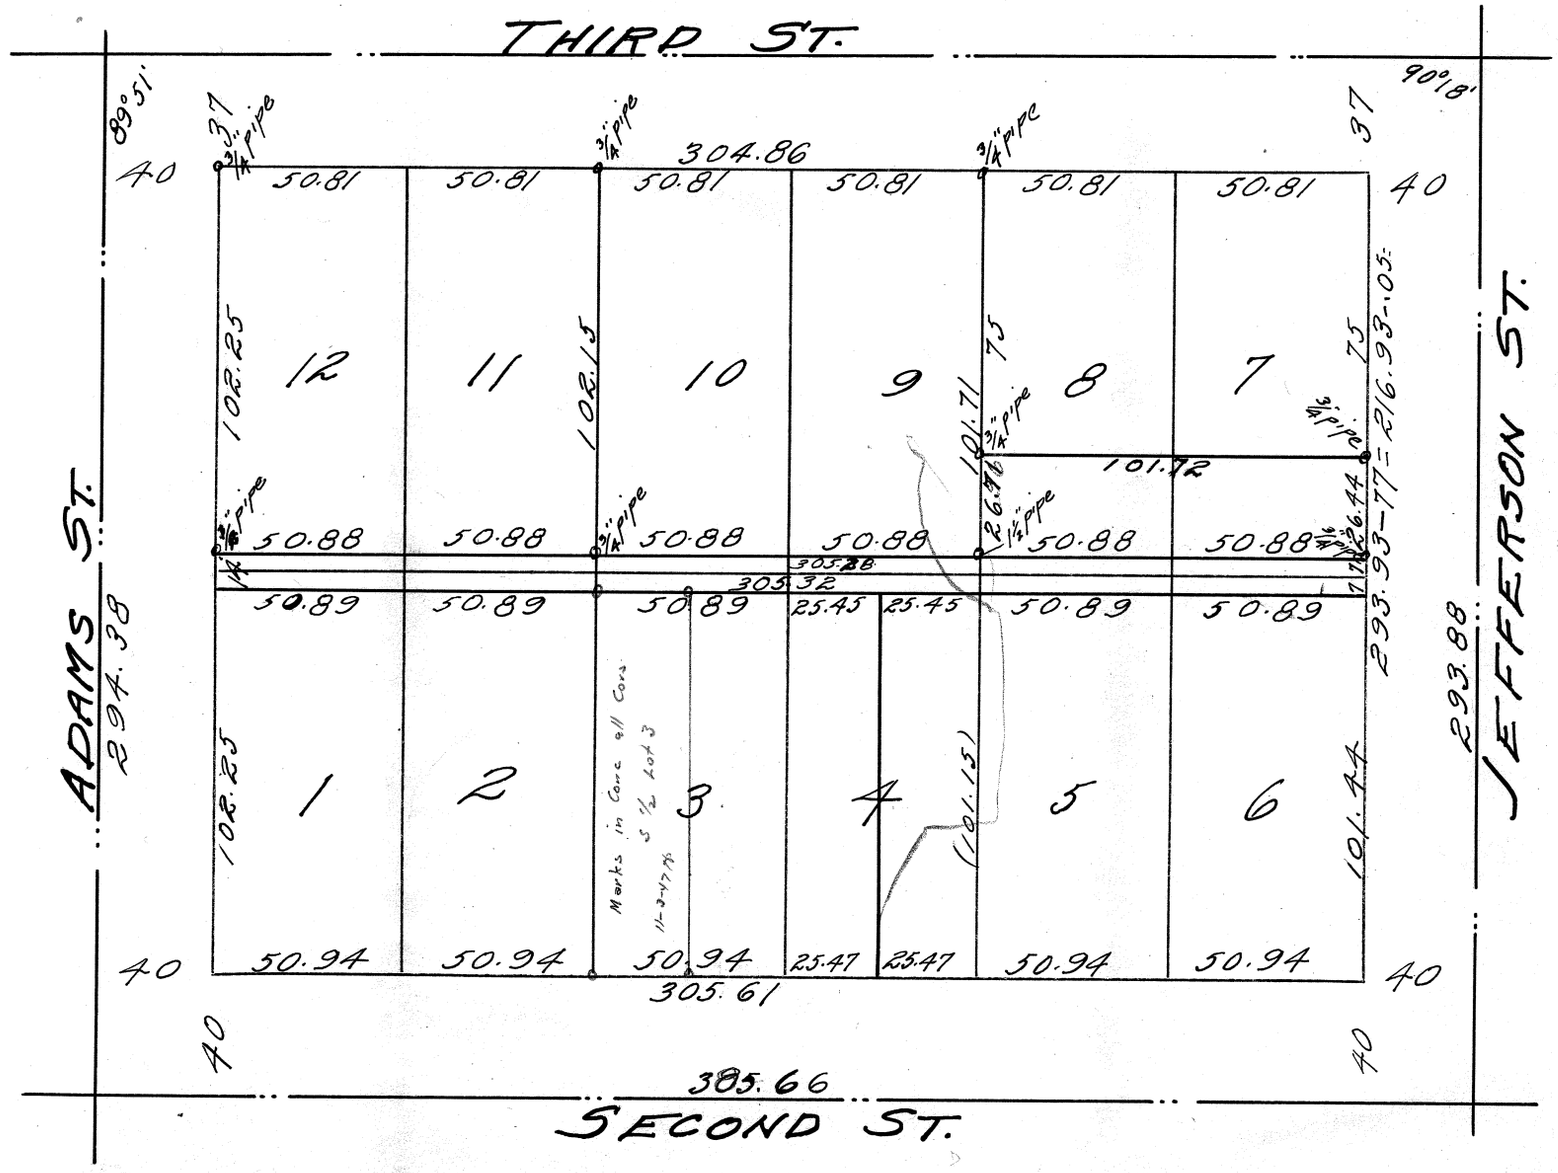

67