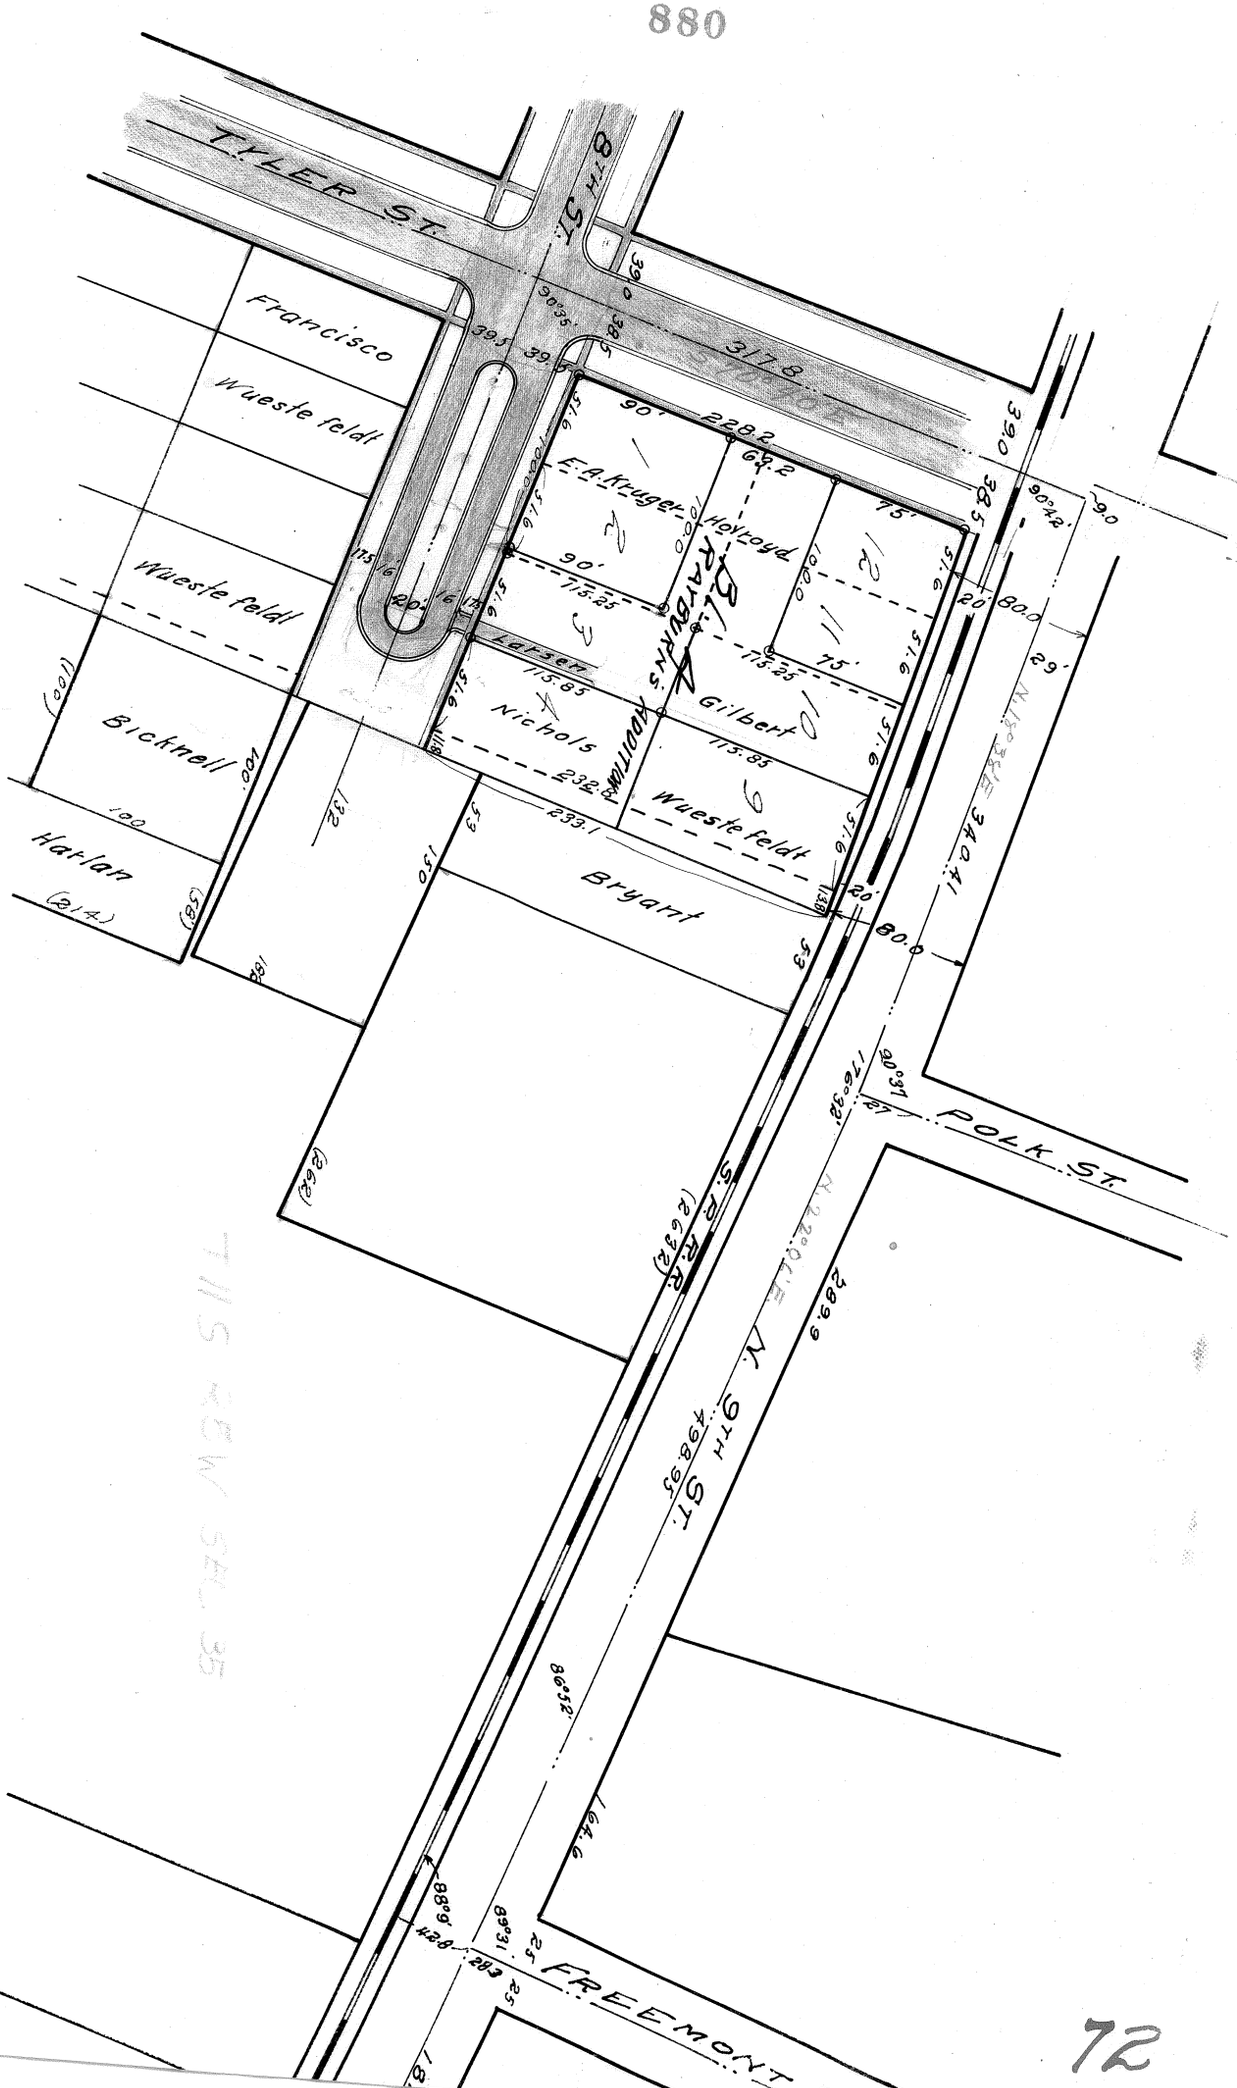
TYLER ST.
8th St.
Francisco
Wueste feldt
Wueste feldt
Bichtnell
Harlan
E.A. Kruger
Holroyd
Larsen
Nichols
Gilbert
Wueste feldt
Bryant
Wueste feldt
S.P.R.R.
N. 9th St.
POLK ST.
FREEMONT ST.

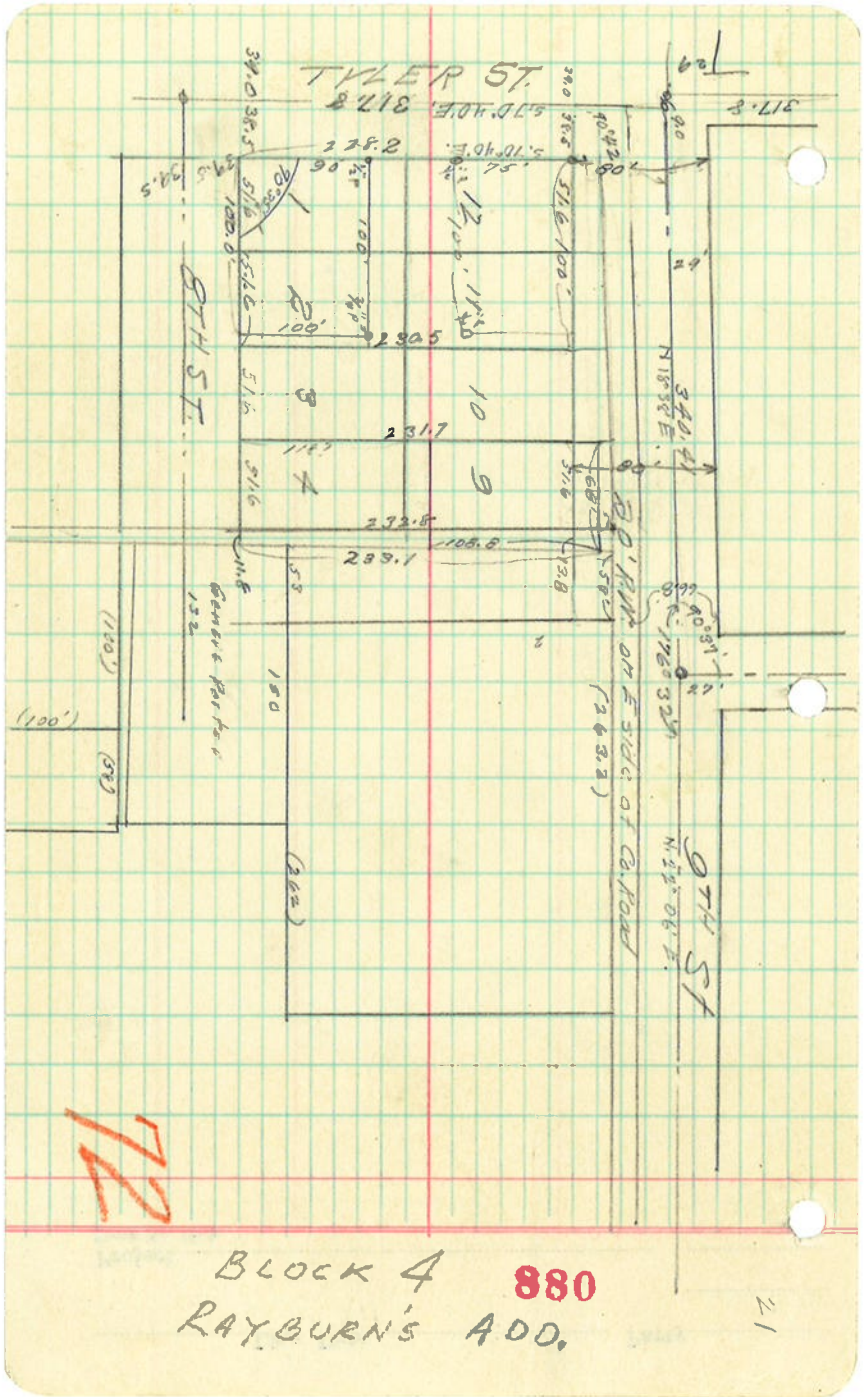
TYLER ST.
S.70°40'E. 317.8
317.8
225.2
90
516
100'
100'
230.5
231.7
232.8
233.1
105.8
128
516
516
516