T11S R5W
SEC 34

881

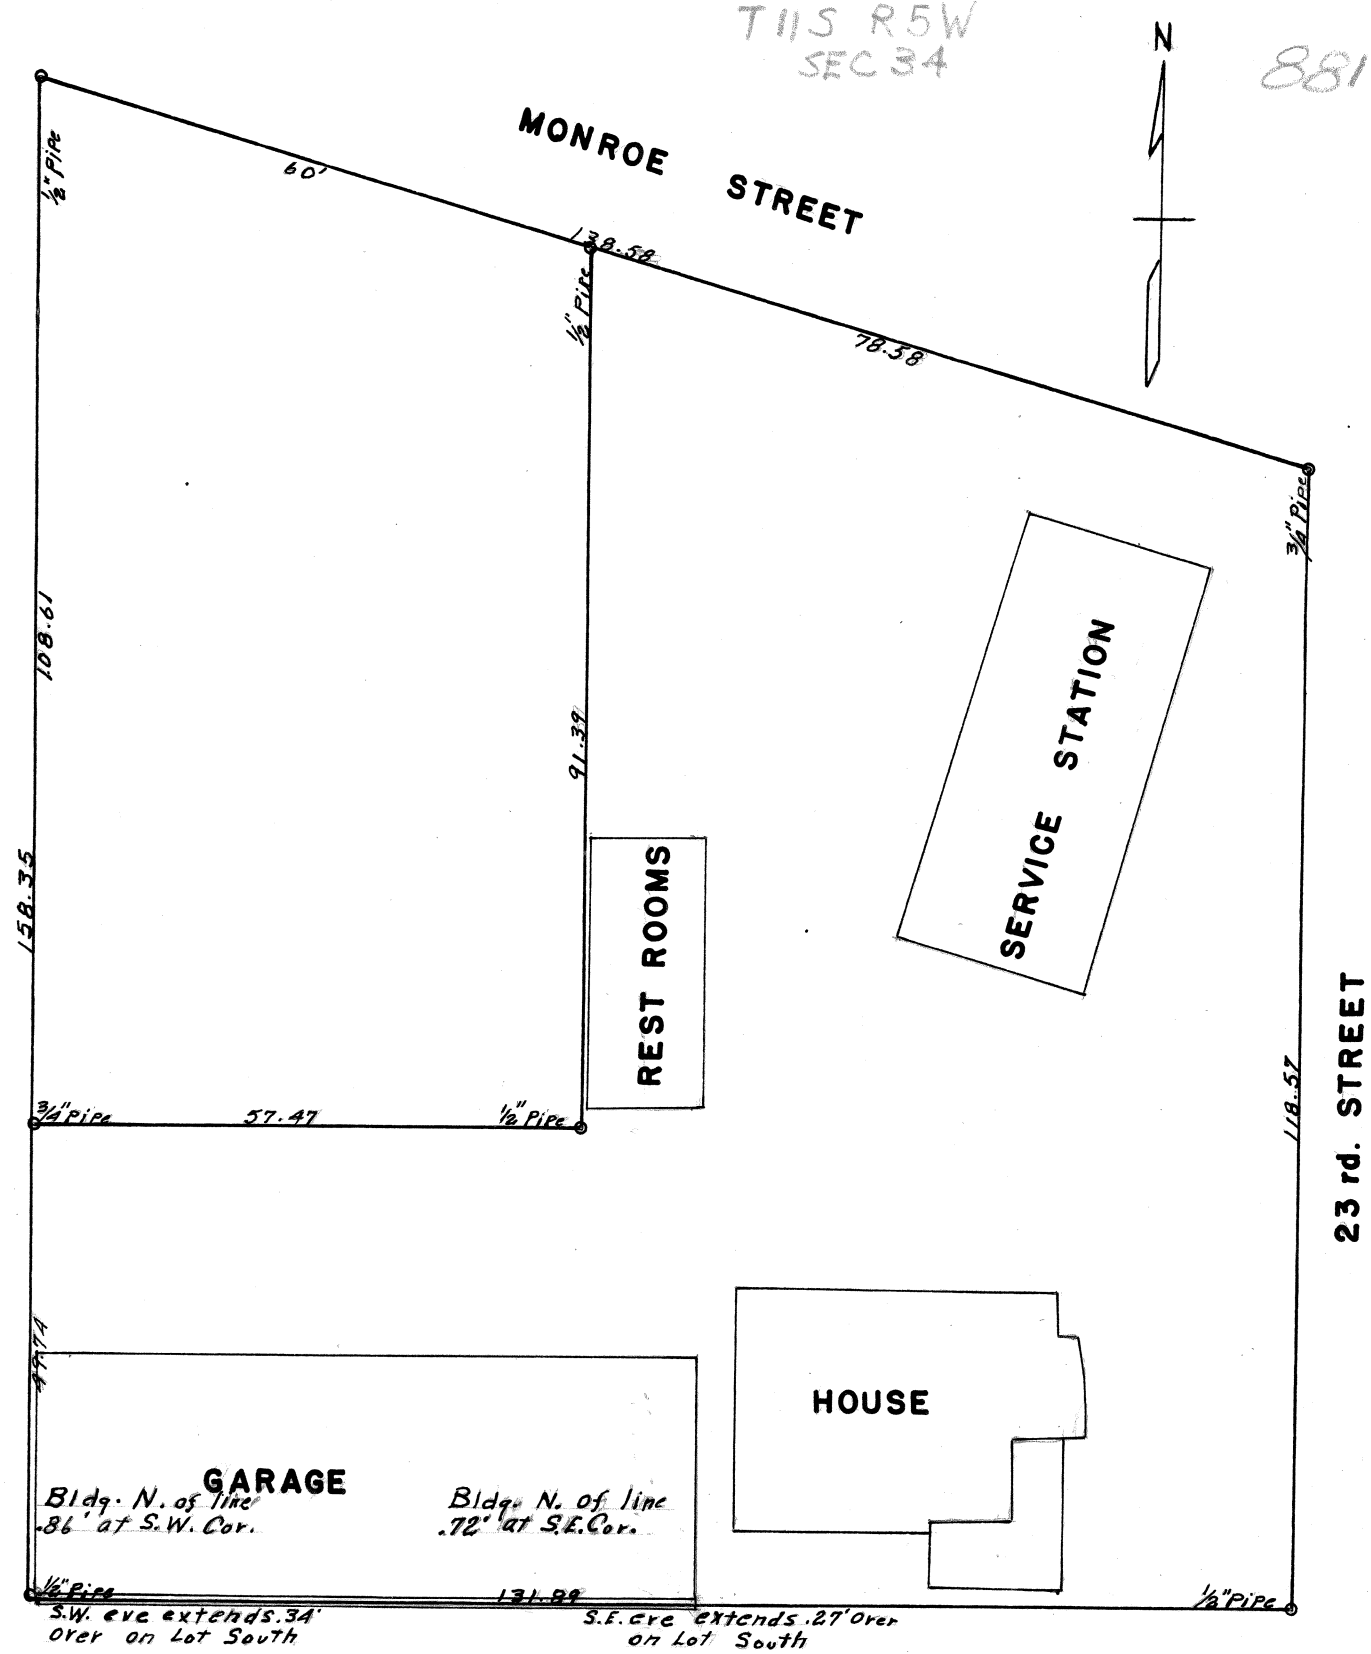

I, W. C. Galloway, County Surveyor of Benton County, Oregon, certify that on July 19, 1940 I made a survey of the Carlton S. Rondeau Service Station property at 23rd. and Monroe Streets in Corvallis, Oregon and find that the buildings on this property do not extend over on any other property except the eve of a wood bldg. as shown on the above plat, and no other buildings extend over on this property.

W. C. Galloway
Reg. Professional Engr. #44

Rogers, Sprague, Coote, & Powers Tracts.

South of Monroe, between 23rd and 25th Sts.
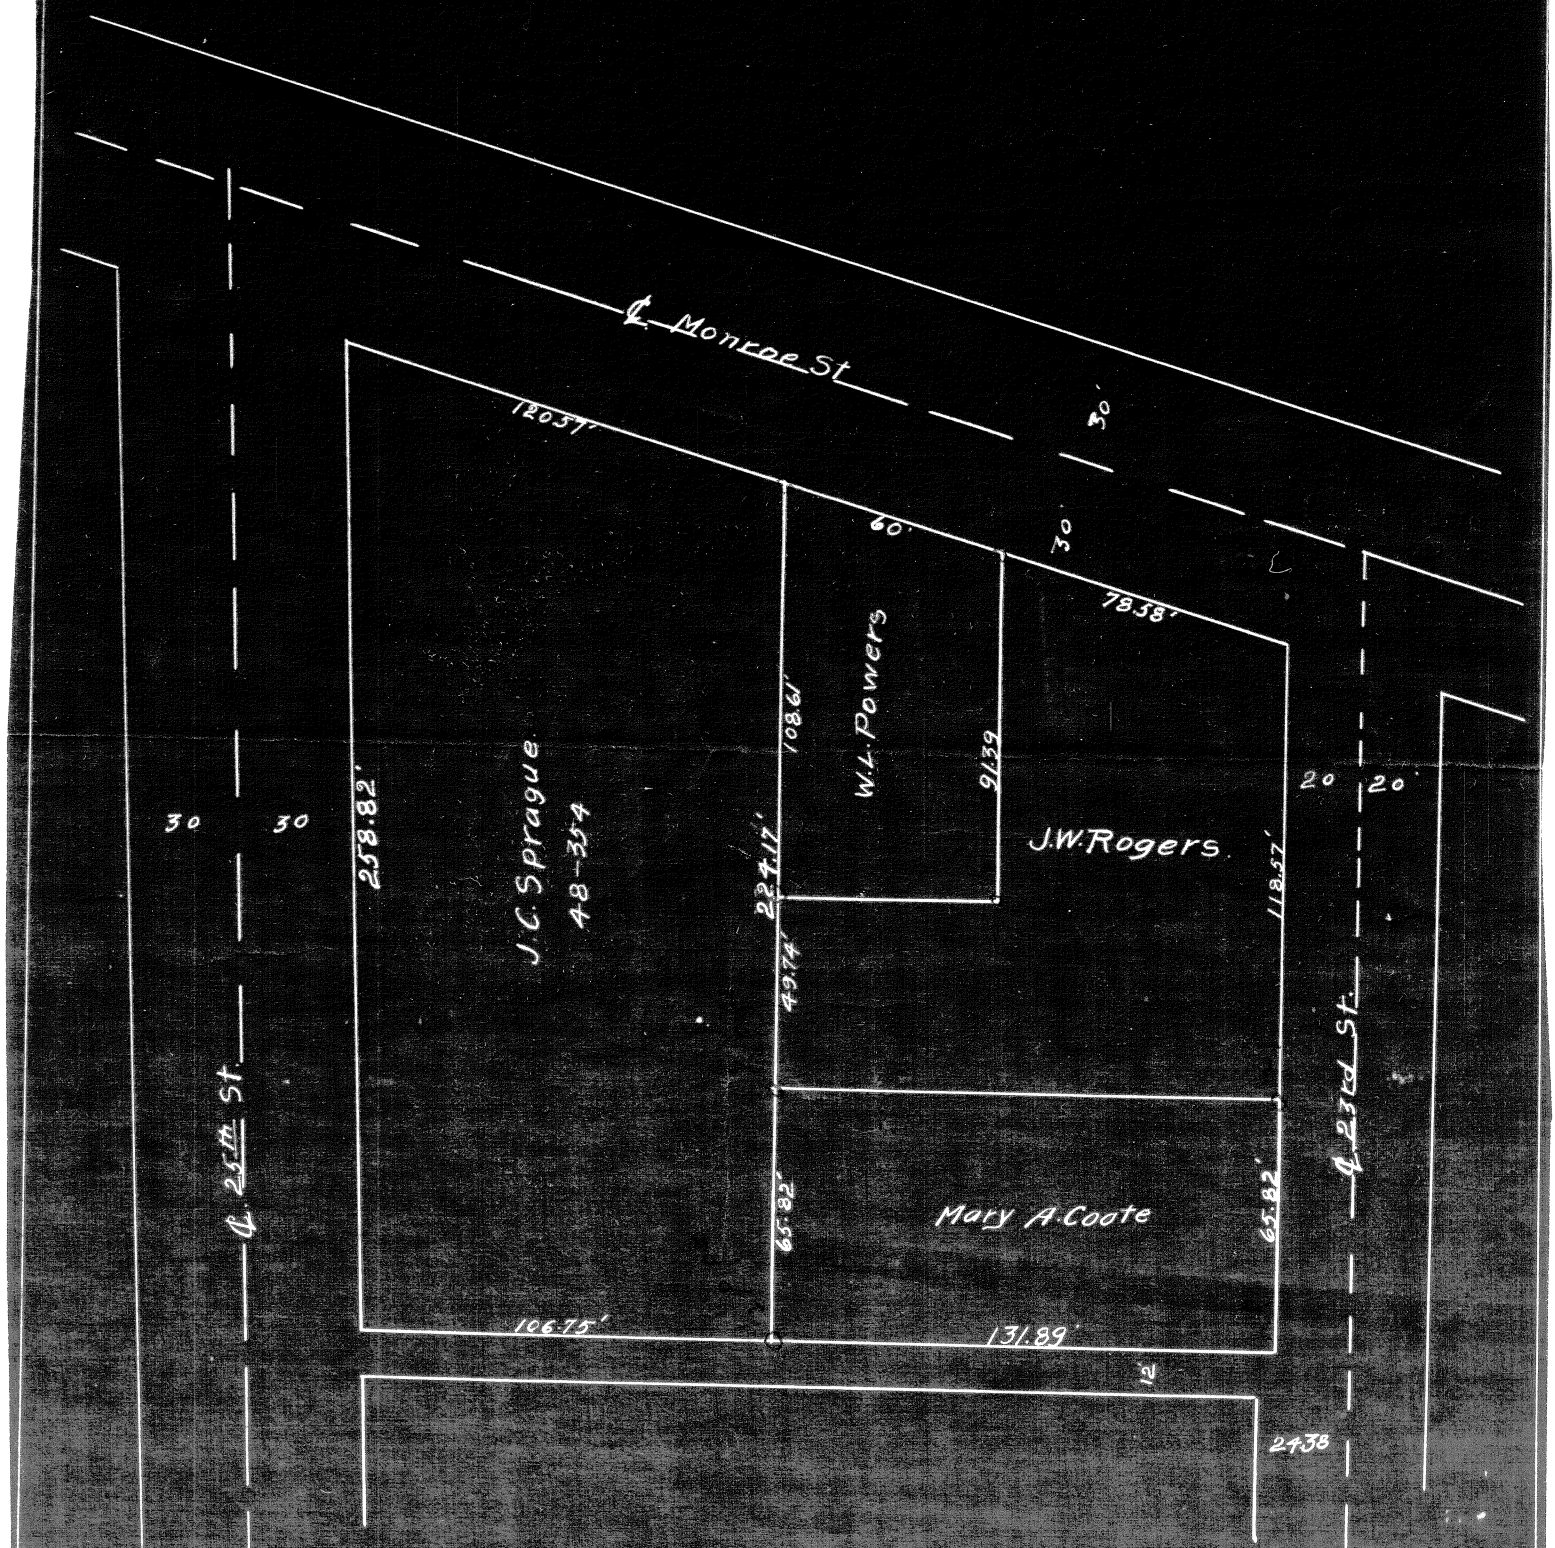
Scale. 1" = 50'