882

BLOCK 2

ORIGINAL TOWN ADDITION

CITY OF MARYSVILLE (CORVALLIS)

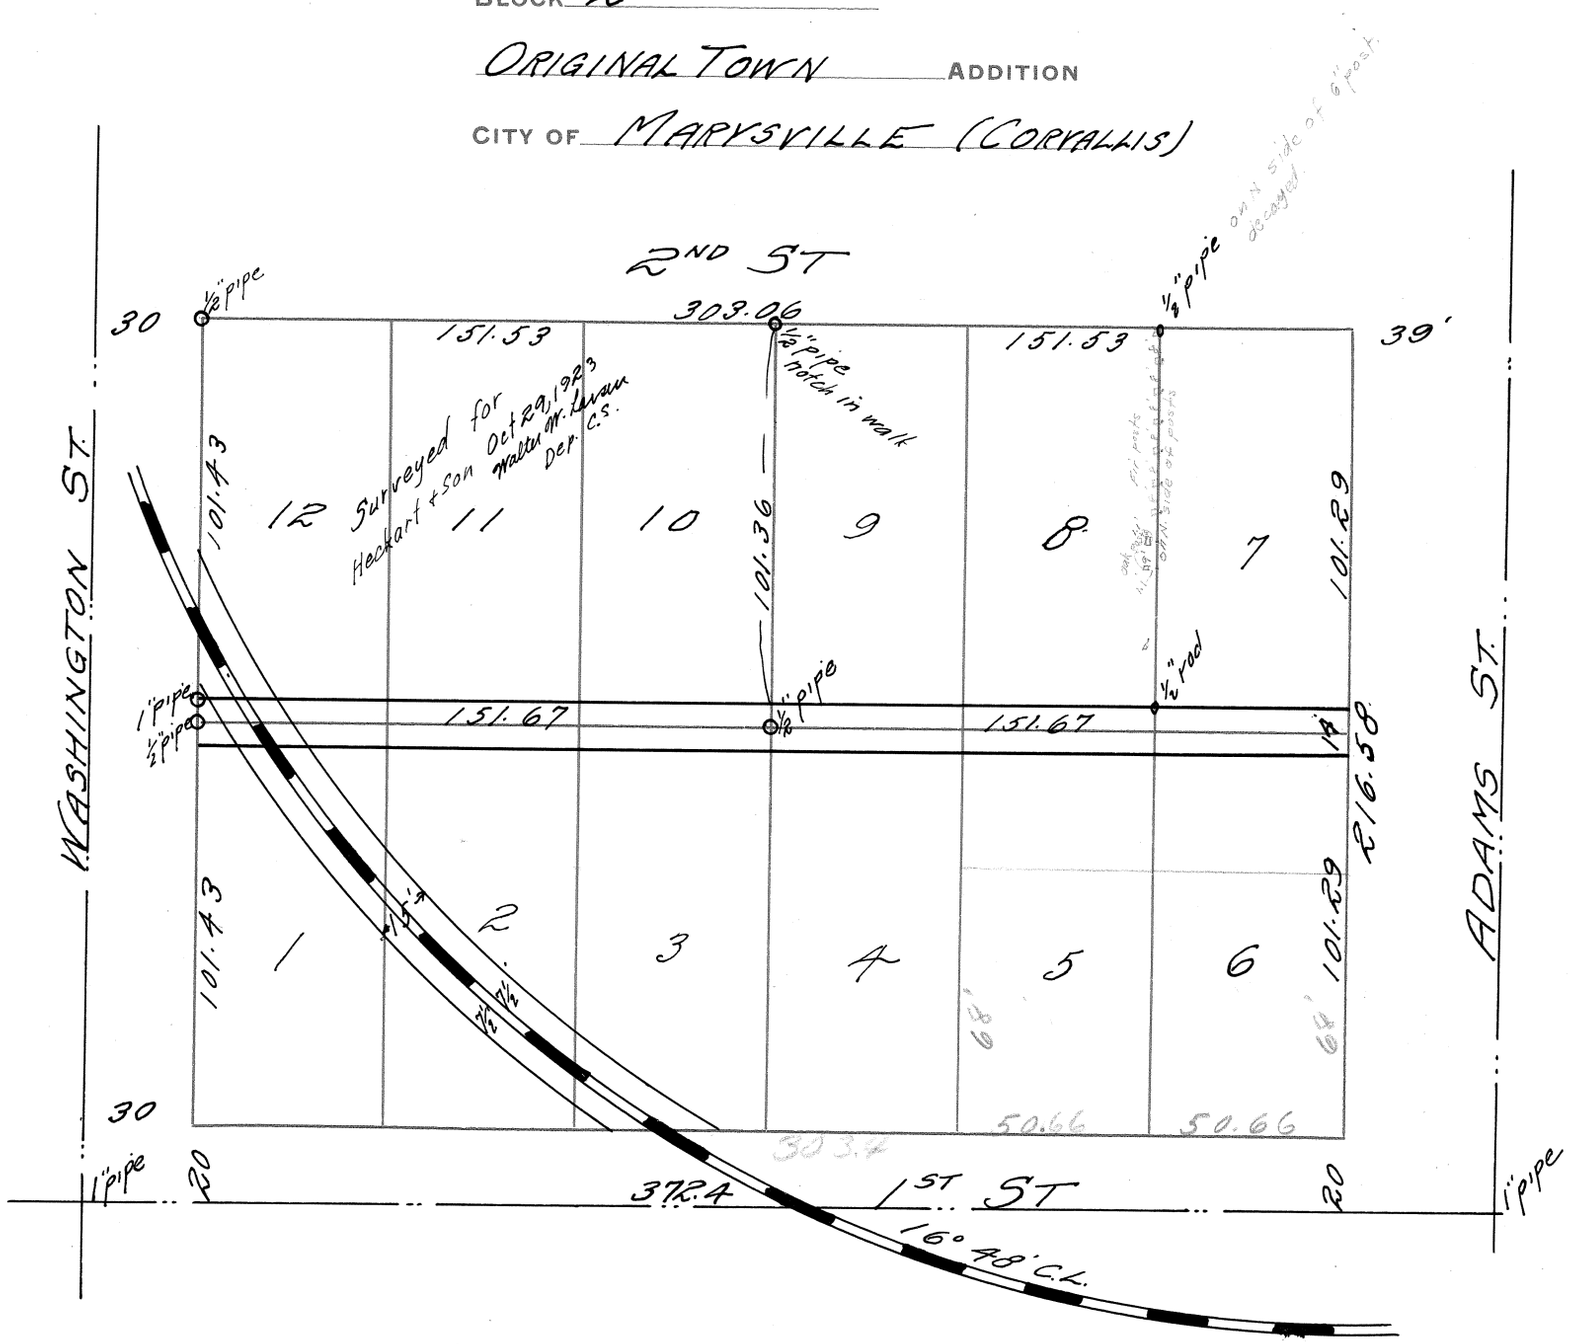

64