885

BLOCK F

Avery's ADDITION

CITY OF Corvallis

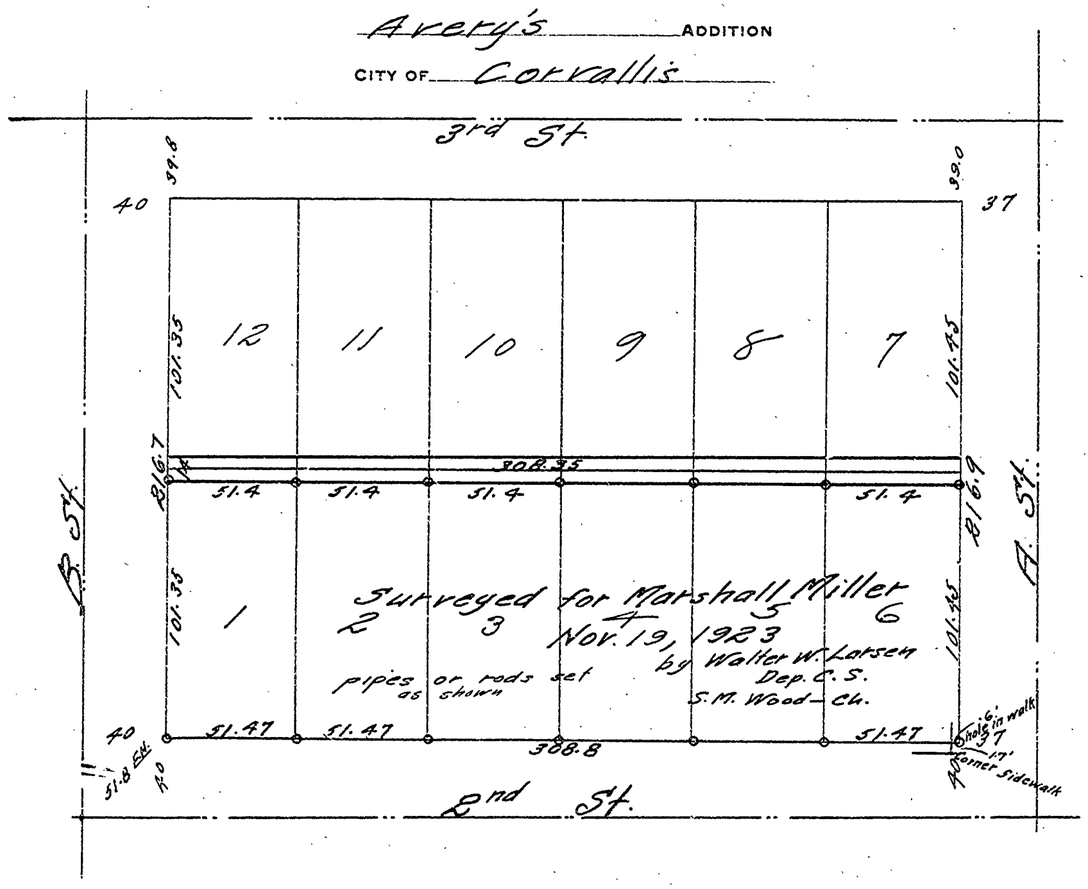

40