886

BLOCK 14

Town of ADDITION

CITY OF Marysville

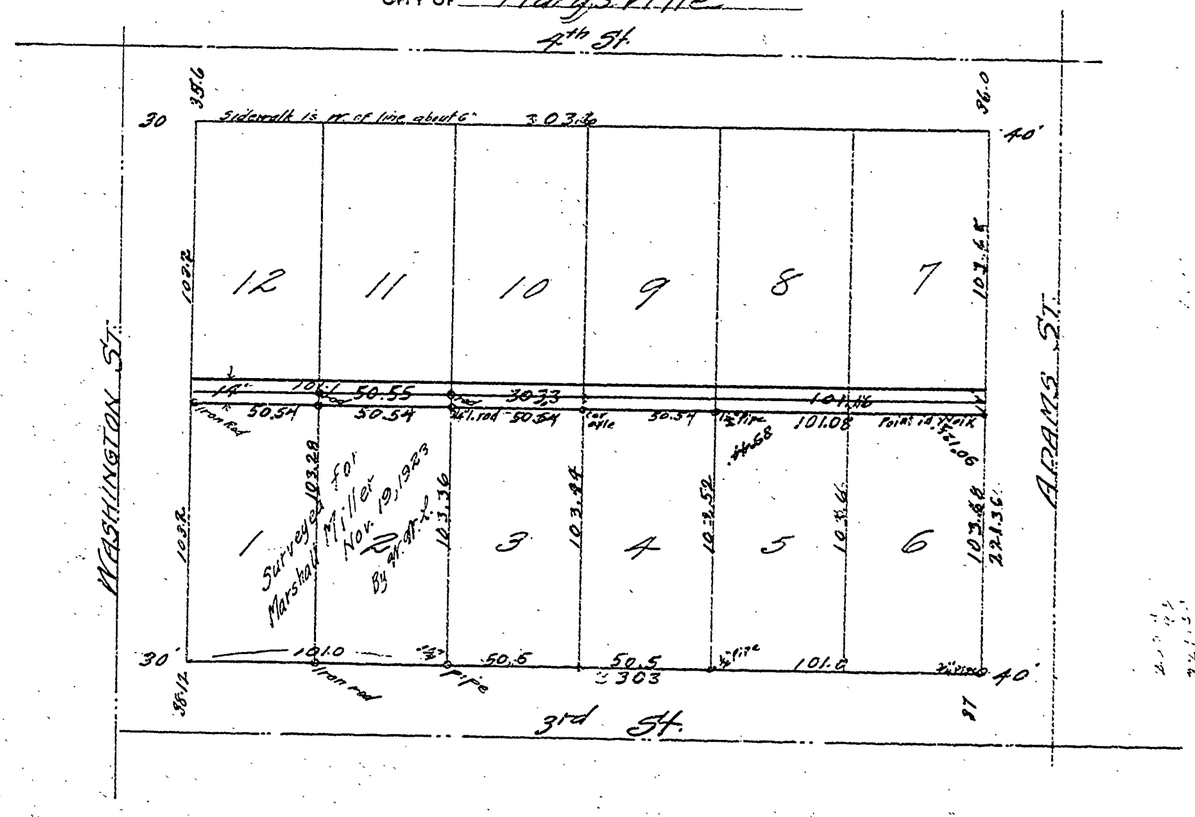

68