888

BLOCK 9

O.T.M. ADDITION
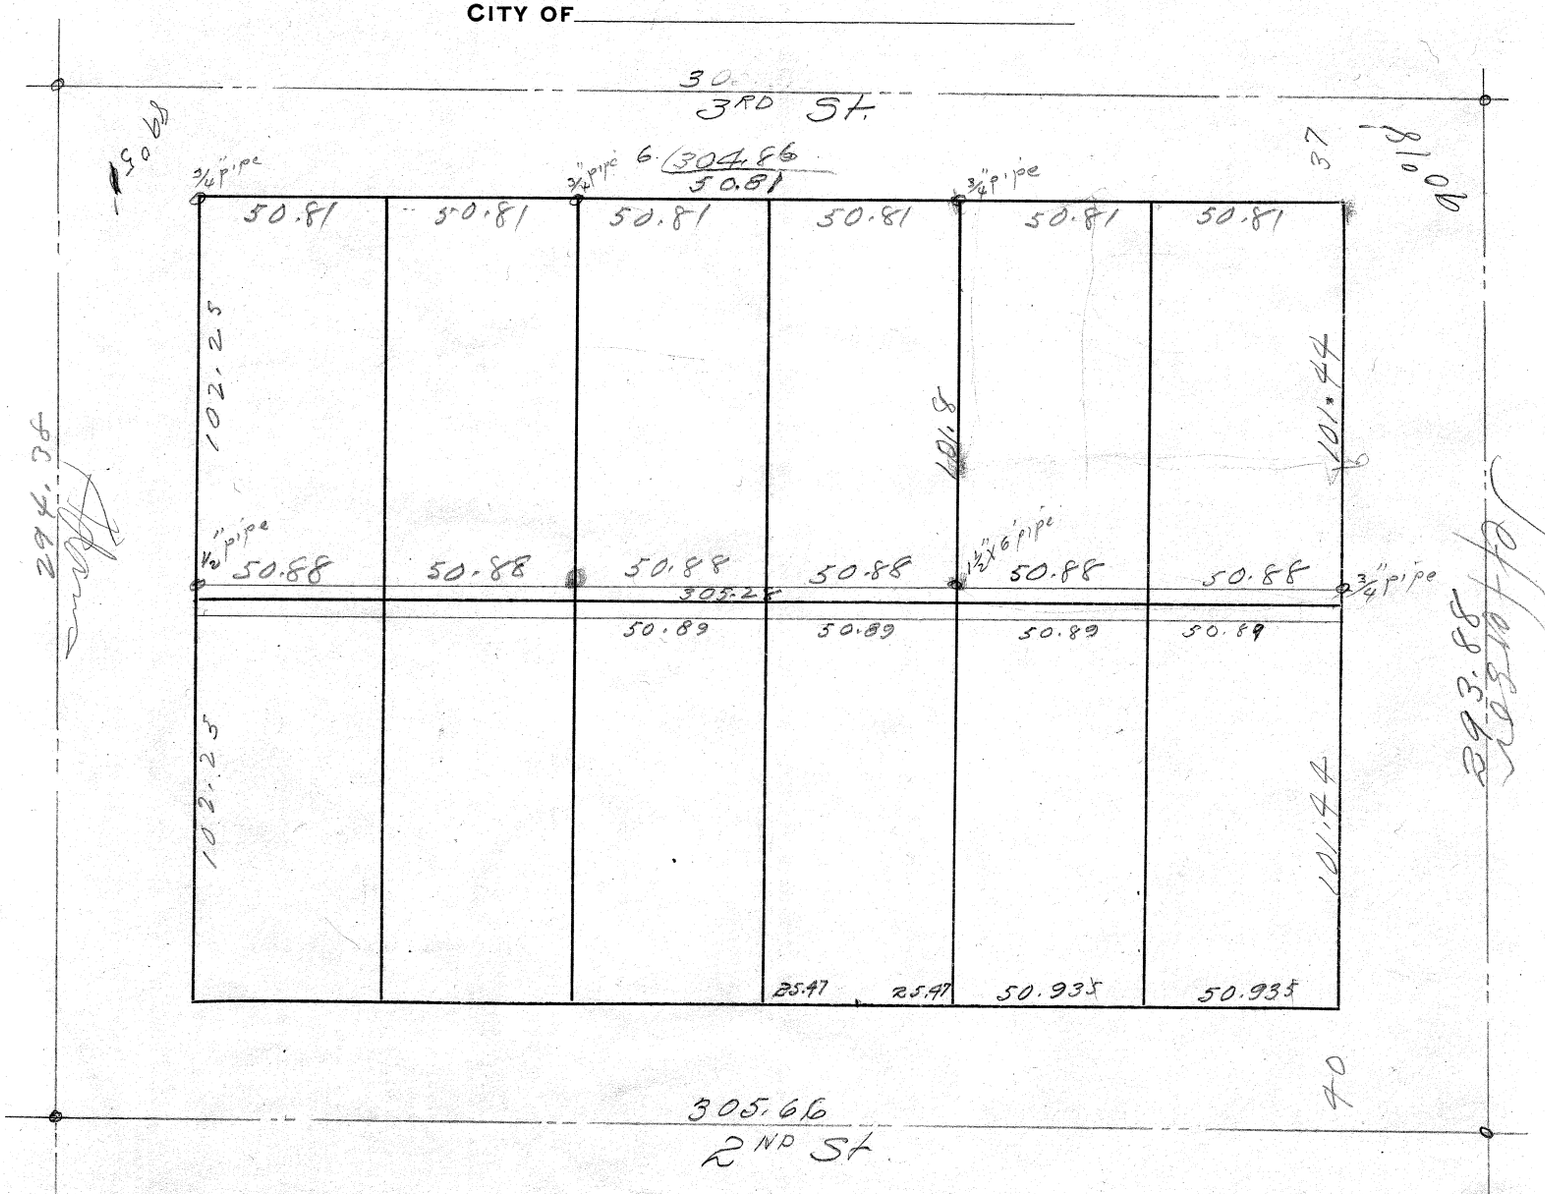
CITY OF