889

BLOCK 2

COUNTY ADDITION

TOWN ~~CITY~~ OF MARYSVILLE

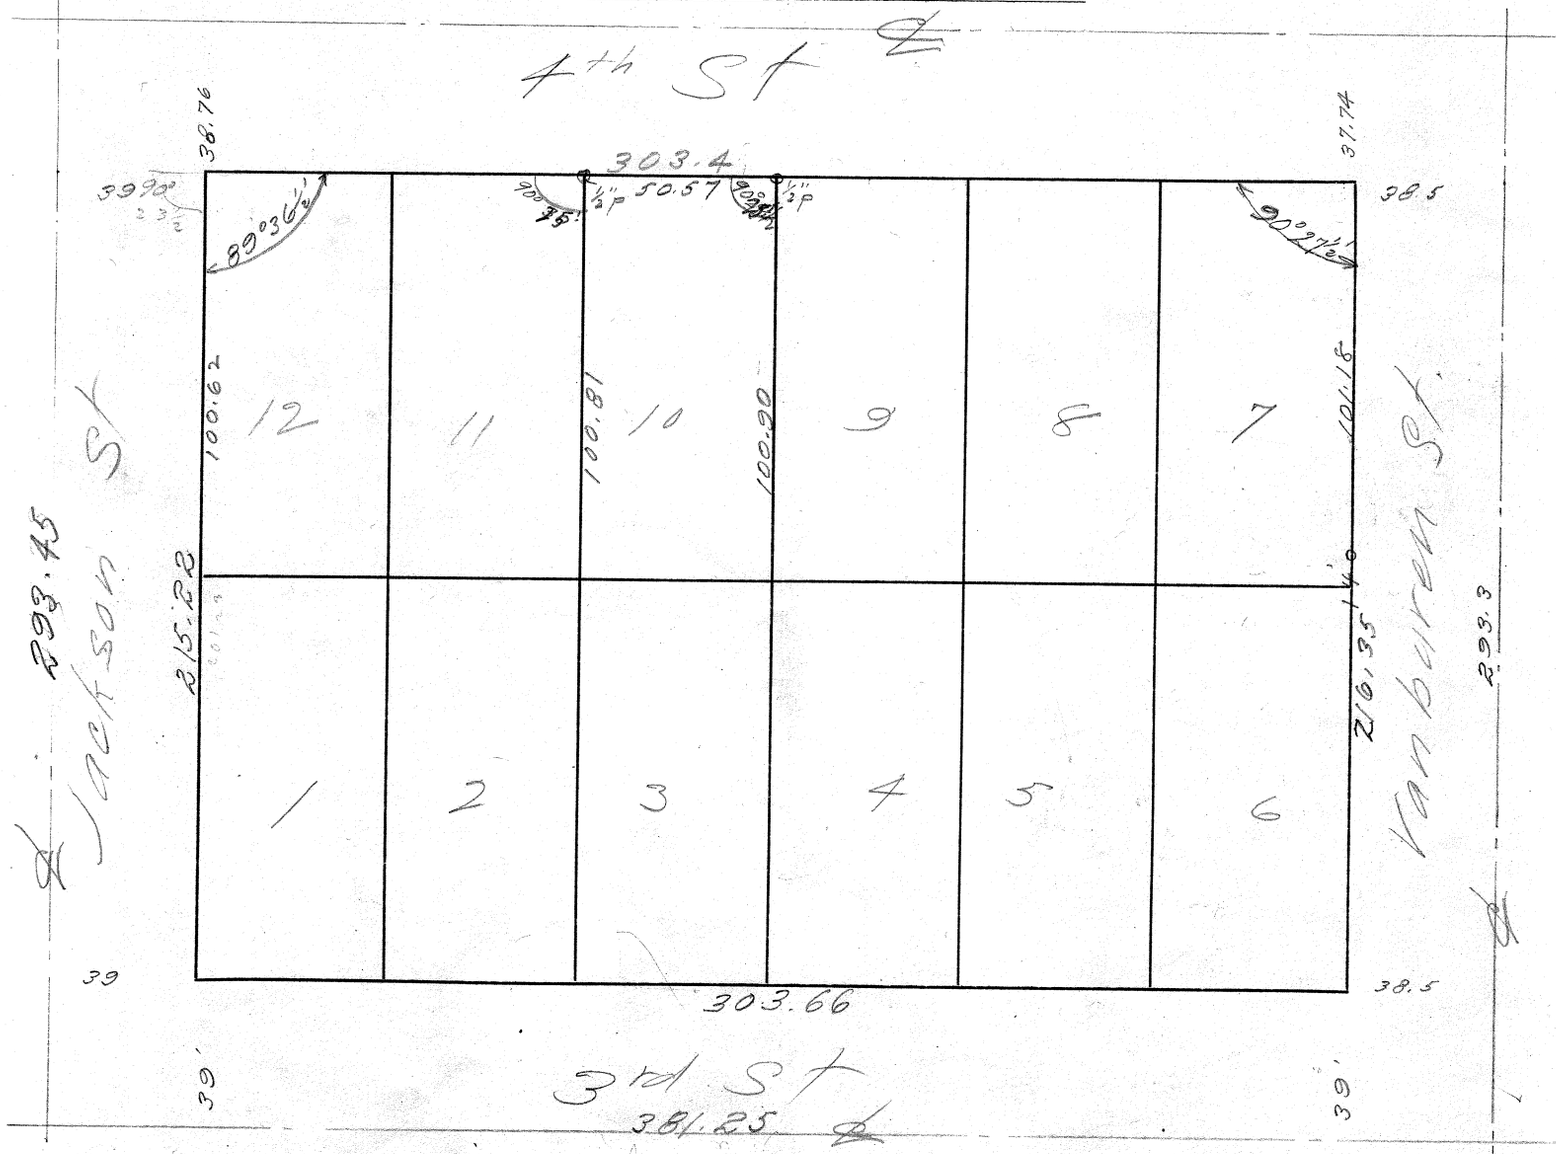


54