C.S. #894

Hardcopy 14-5 #2

also see notes in file

F. B. 31-22

22

F/B # 31, PG 22-23

#894

C.S. 298 T.14-5

Beg. at △ which is S.083 E.006 From M.C. on W. bank of Mill River on line bet. Secs. 1 / 12 T.14-5 Thence along River from beg. of Sec. line

1	N. 48° 37' W. correction W. 36'	7.822	7.816 .32 to Walk r.
2	N. 76° 39' W.	7.597	
3	S. 87° 38' W.	1.557	
4	N. 49° 52'+ W.	15.575	1.70 - 50 to R. E. 90 to R.
5		6.982	N. 10° 40' E 1.25
6		4.853	N. 14° 35' E. 4.26
7	S. 49° 52'+ E.	.175	=11.235
8	N. 80° W.	4.885	N. 35° W. 1.80 N. 17° E. 2.96
9		8.462	at 3.75 N. 75 E. 70 to corner 415.20 N. 23 at 2.00 E. 92
10	N. 35° 24' W.	11.137	
11		.510 =	
12	From △ 10 N. 83° 55' W. 2.737		
	From △ 11		
13	S. 46° W.	14.264	3.53 N. 47° W. slough
14		2.685	N. 4° W. 388 to 403 ℄ S. 85° W. 2.60 to 2.92 ℄

551
4.87
10.38

For Hugh Finley Estate
Feb. 27, 1924.

2 | 1
11 | 12

S. 89° 33' W. 36.00 50 1.064 S.
S. 89° 39' W.

7.822 | .08300 = .01061 = 36'
7872
47932
46980

.00188 = 6'
36.00 . 06 11
36
at -5.50 .80 to R. 280
at -2.20 1.44 to R. 252
280

at 6.00 in line with bank of river upstream @ .70 from river. at 8.00, .32 to old River.
N. 9° 40' W. 3.00 River and continued for W. of River.
N. 24° 05' E. 7.23 Bnk. 7.60 ℄ cr. + W. of W. Hancock
N. 30° E. 7.12 " 7.42 ℄ "
Bnk + Green. cr.

4.885
8.462
13.347

+30 +30 +30 +30 +30 at 18.00 N. 55 W. +30
at 3.25 E. 1.17 +30 at 7.66 E. 40 +30 at 8.60 N. 50 +30
N. 74° E. 2.55 Bnk +40 N. 60° E. 2.60 +40 N. 40° E. 2.45 +40
N. 68° W. 1.32 Long Tom N. 17° W. 1.20 N. 27° 30' E. 2.19 E. Long Slough

at 4.67 West Line 2.71 To Slough +75 Cont. +60 To Long T.
40 N. they come together
at 10.38, N. at Line 1.94, S. 50 ℄ Long Tom West. S. 1.20 Bnk. S.
Slough & 7.00 bnk. Long Tom

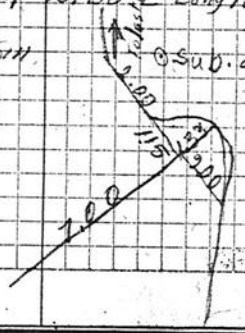

11.137
.510
11.647

23
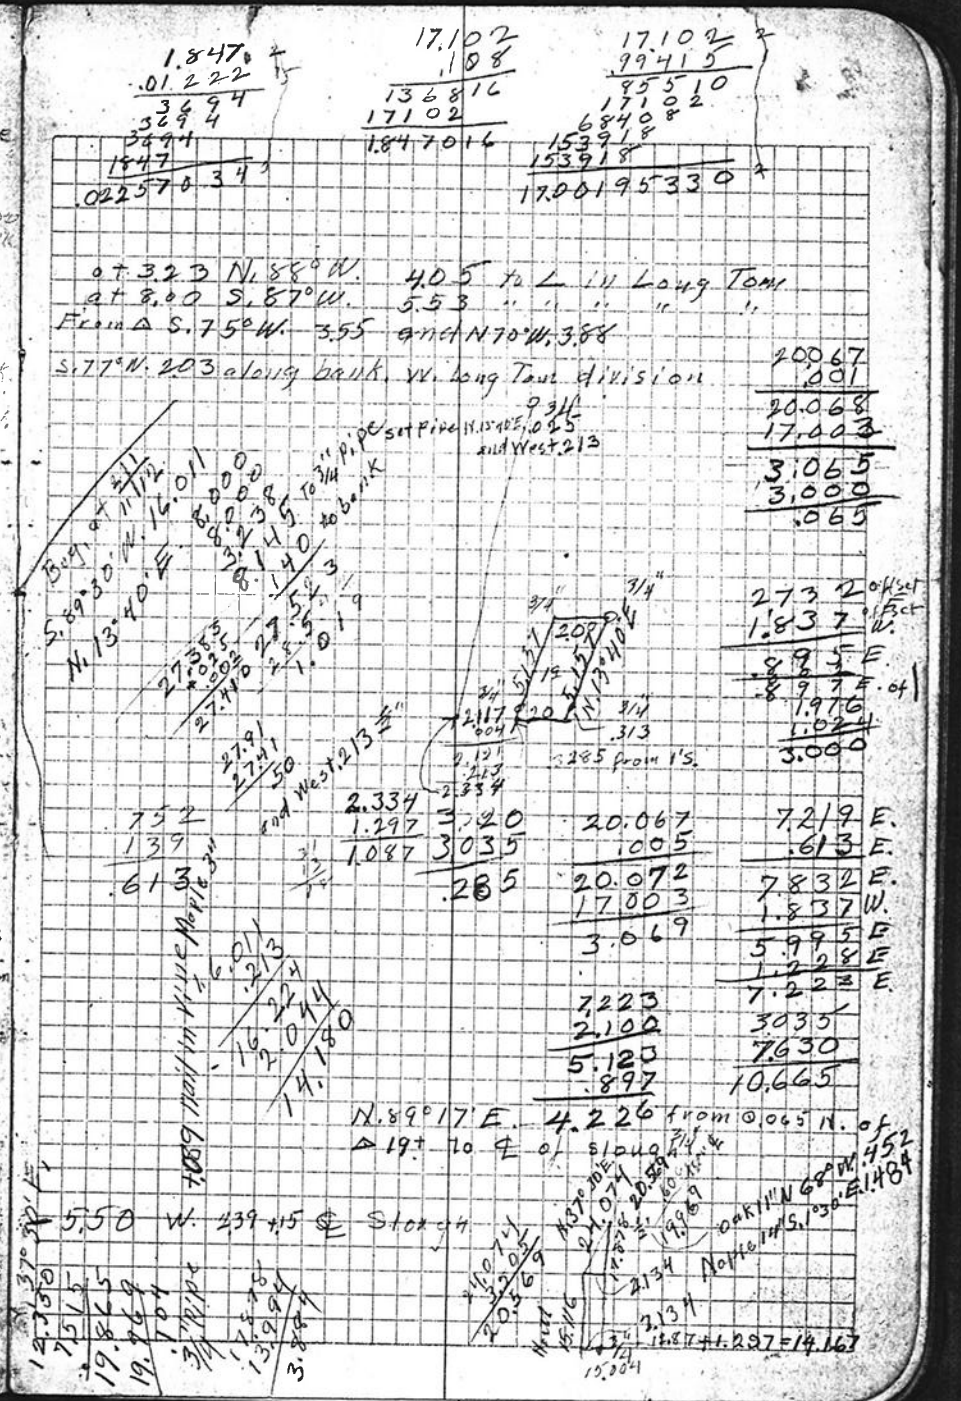
	Came to	2 / 11	Backsighted along line	
	N. 89° 20' E. then			
15	S. 89° 20' W.		2.793	Bnk +.30 low Bnk
	Back To 2 / 11		and	
16	N. 6° 10' W.		14.082	
			3.020	+.30 Bank +.80 low bank offset from line 1.837 W.
17				
18	N. 89° 20' E.		2.732	
19	N. 0° 02' E.		1.976	
19+		-9°15'	1.037 = 1.024 +.065	offset E. .002
	& N. 89° 17' E. →			
From △ 19				
20	N. 89° 20' E.		7.219	
21			.613	
22	N. 21° 43' E.		3.035	W. 1.79 + .30
			+.285	This ⊙ is 7.223 N. 89° 17' E. on Subd. line from line thru ¼ of sec.
	S. 89° 17' W. →			
25			7.630	To △ 13
	N. 46° E. along line To △ 11