C.S. # 897

See notes in file

F.B. 34-13

13 FB#34 C.S. 93 C.141 T.11 4

897 Survey for Kinney + Kyler on Harris place
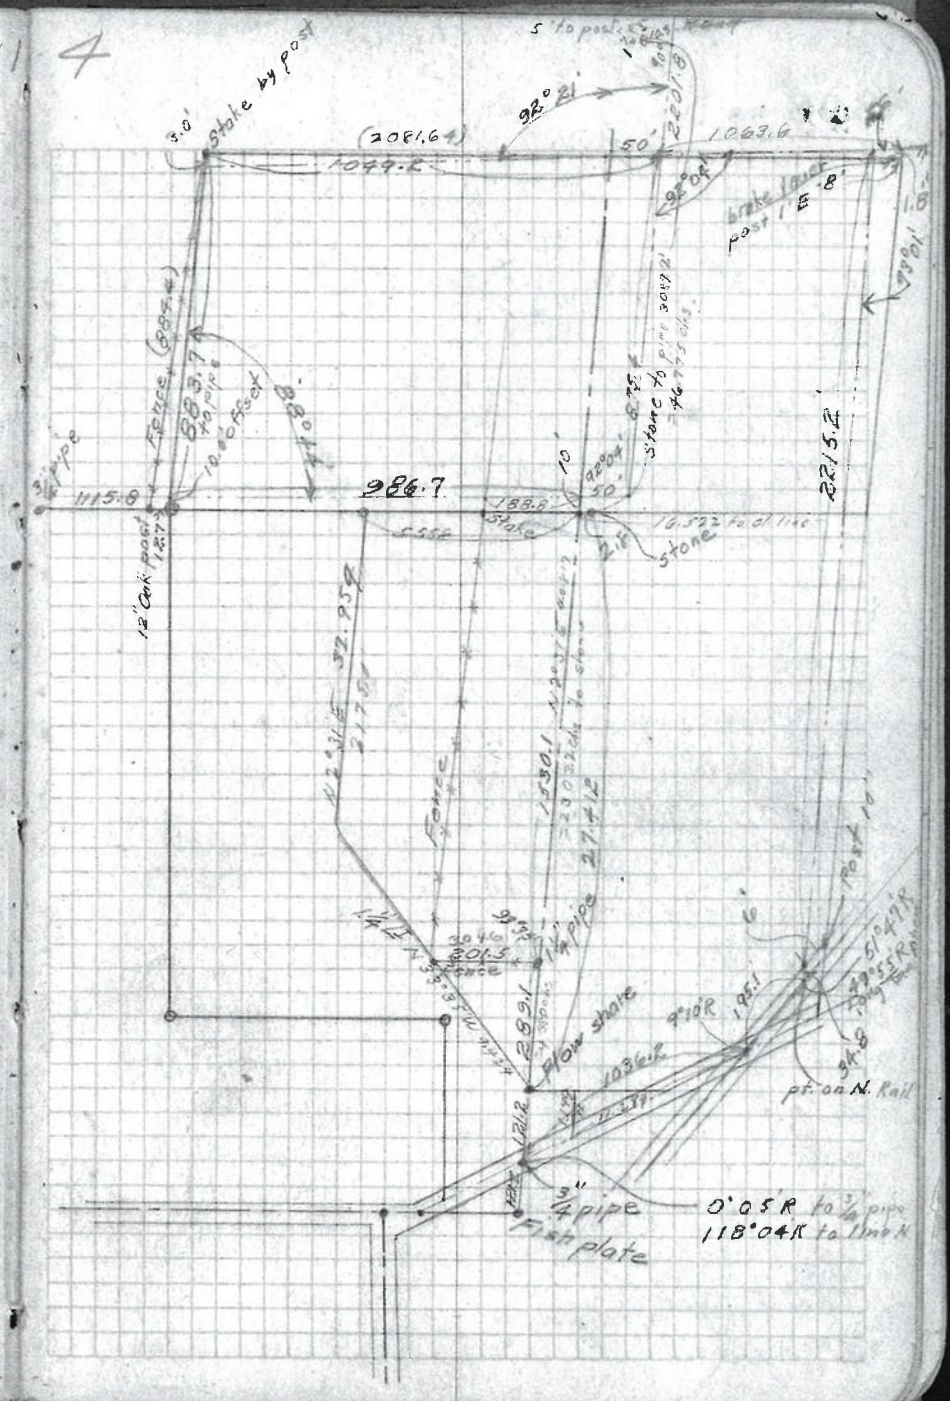
Set brake lever S. 004
Set N.W. cor of E tract S.015 W.419 of line