C.S. # 899

See notes in file

F.B. 34-17

17

899

FB#34
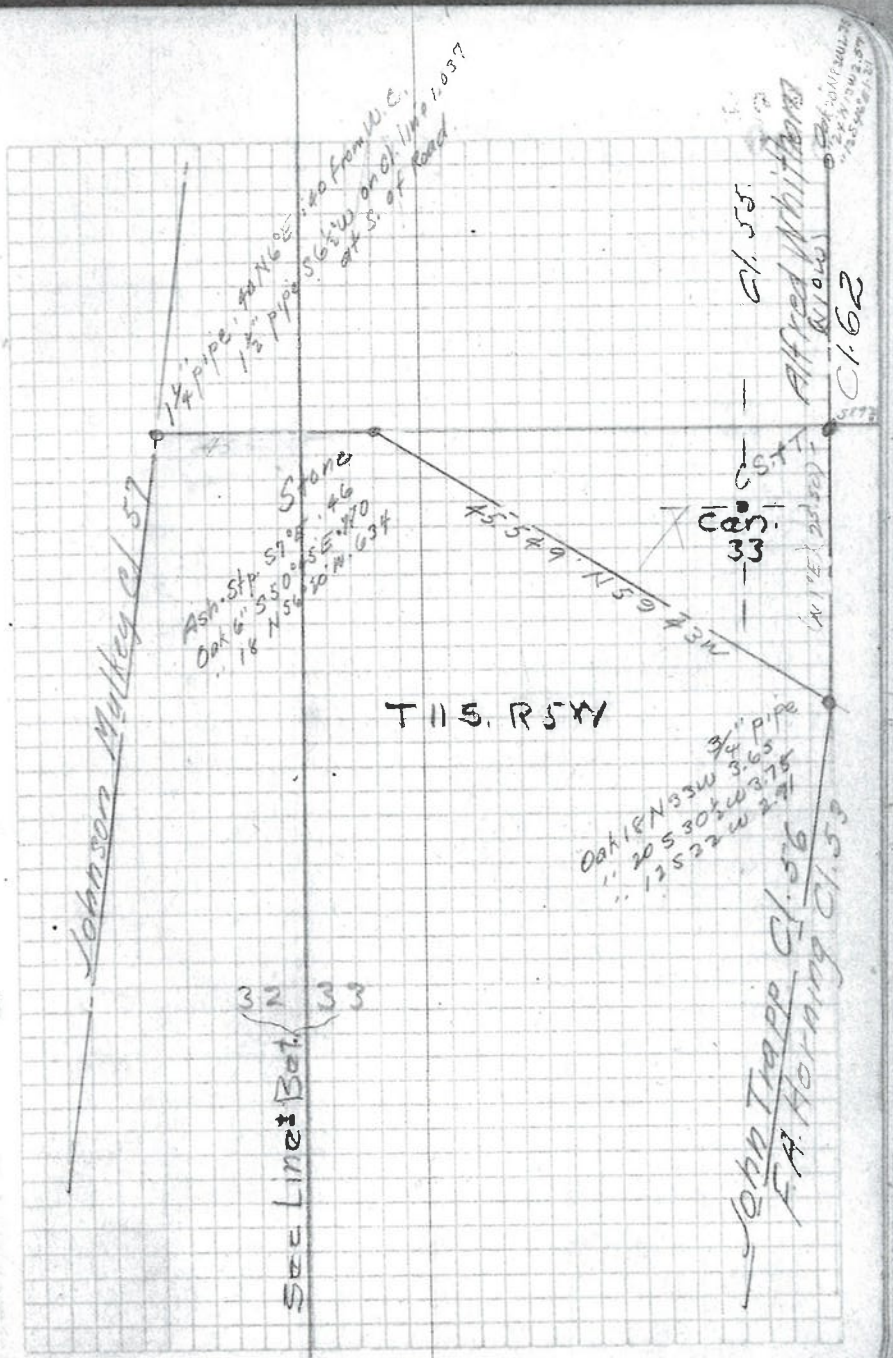
Survey for M. S.
road cock.