C.S. # 900

Hardcopy 11-5 # 22

also see notes in file

F. B. 34-18

CHAINS

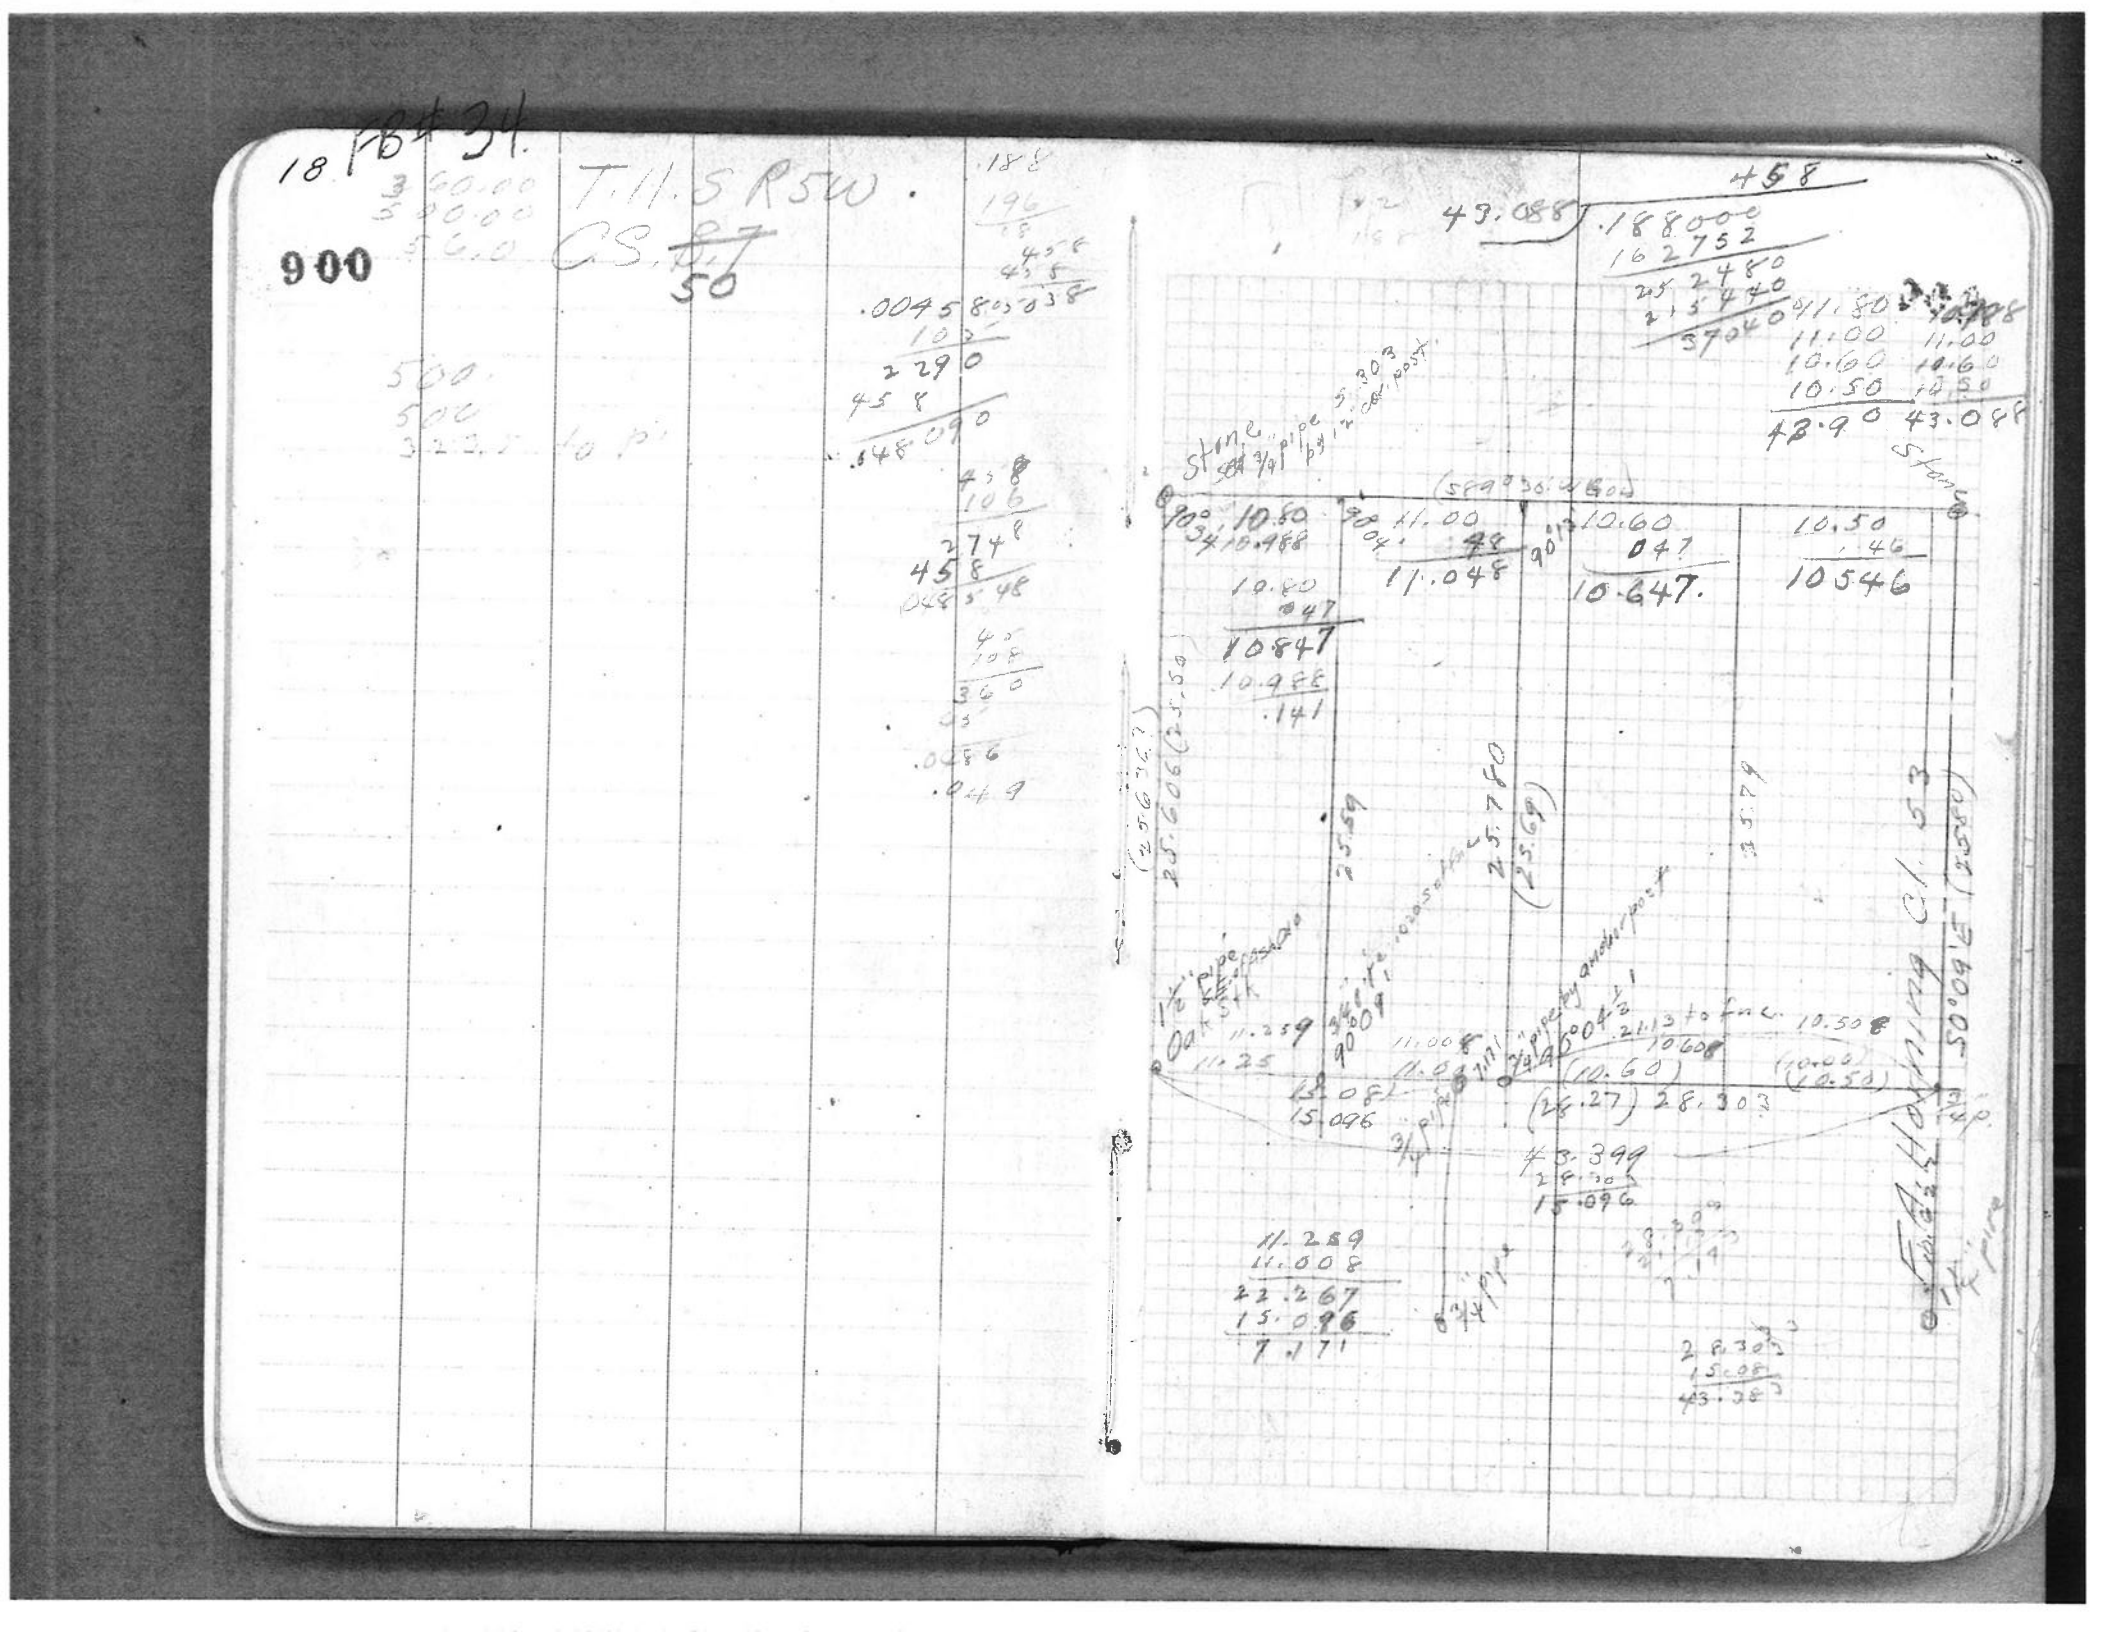
T.11.S R5W.
CS. 07
50
900
43.088
10.60
11.00
10.50
10.647.
10546
11.048
10847
10.976
.141
11.259
11.008
22.267
15.096
7.171
43.399
28.303
15.08
43.38
Stone
Stone
Stone