C.S. # 902

Hardcopy 11-9 #5

also see notes in file

F. B. 34-23

MAINS

23902 FB#34

Sec. 2
T11-4

C.S. 333 10-4

Set on Bolt A F.S. W on B

turn 90° 11' L Run South

+4°50'			
2.791	2.776		
5.000	5.000		
+6°10'			
2.097	2.085	1+39.4	
4.615	4.612		Set .092W
		1° 38' L	
5.000	5.000		
2.443	2.445	7+43	— 4.590 + .288W
			.212 E
		90° R tot	Set .352W
.372			
			Set .020E
		8° 38' R tot	.372 W
			~~1.646 W~~
-5°15'			
5.000	4.980		
-6°19'			
4.398	4.372	9+24.2	
		17° 56' L tot	1.404W
-4°			~~.647 E~~
2.190	2.186		
-13°20'			
2.650	2.576		
-21°51'			
.633	.590		
		0° 0' tot ang	1.648E
			Set .316W
-12°55'			
3.655	3.561		R.R.
N Rail ∠		39.939	Set S.234
			+ W.339 ∠ 81°46'
4.094	4.094		
		+15 SW of SW cor Hse	
5.000	5.000		
4.184	4.184		
-10°0'			
1.995	1.963		
		0° 17' R tot	
4.810	4.850		

See page (34)

J. A. Howard Albany

39

Red = Road

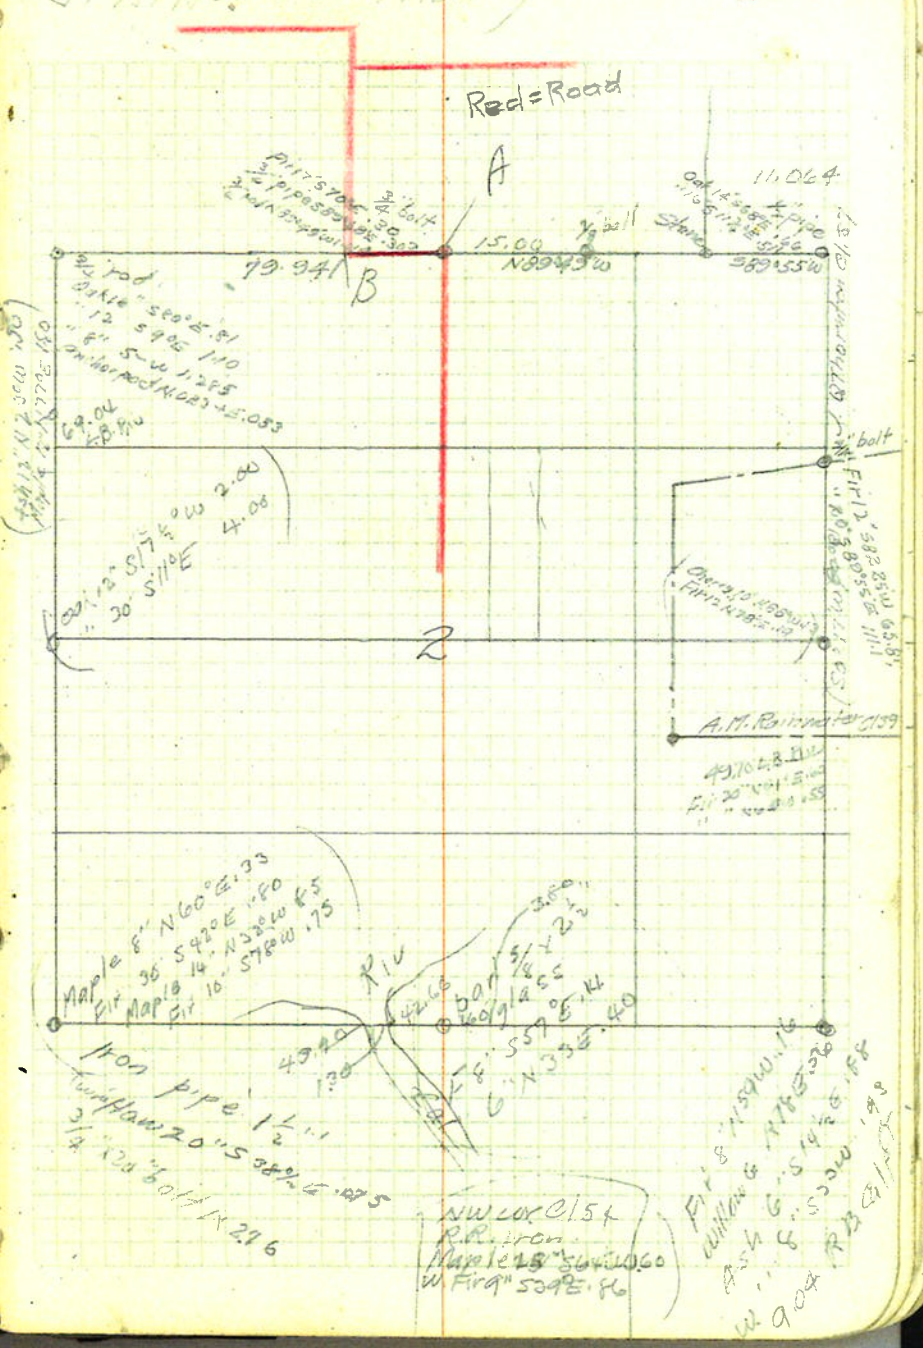

34

902

Sec 2

C.S. 333 T11S R4W

Began at a rod 1/4 cor N. sec 2 — 1/4

South

3.244 3.244

2.507 2.497

1.573 1.573

9.772 76.878

12°15' R

3.170

Back to new 20 ch 90° R .995

40.000

92° 14' R

1.610 1.610

.845 .845

4.155 4.139

1.432 1.434

5.000 4.995

3.000 2.988

2.000 2.006

5.000 4.878

1.885 1.814

3.141 3.131

2.976 2.916

3.043 3.030

33.965

82° 28' R

.357

set ½ pipe .51 W of line

.109 W

S. H. Howard 304

on Beamis Tract

.812 E
.372 W
.160 W
1.404 W
1.564 W
1.648 E
.084 E
1.104 W
.085 W
.995 W
1.020 W 76.878

67.20
9.77
76.97

14396
7443
9.246
5.093
3.561
49.739
15.843
21.896
76.878

0°46 W

97.72

93° 05'

72° 39'

Fd. 36" N75°W .6E
Maple 24" N15°W .2 W

.1255
.0064 = 0°22' W

98° 14'
81° 46'
17

5.000 5.000
5.000 5.000
5.000 4.994
5.000 4.994
2.042 2.036
5.000 4.994
5.000 4.996
5.000 4.996
3.910 3.902 40.912

99°44' R

5.755 .973 5.672

1.876
2.834 4.998
5.013 "
3.709 3.709 5.009 − .011
1.309 1.300

2.324 2.271
2.726 2.701
4.997
4.989 + .009
= 4.998

Set Stone 8x8x16" on fnc line
Oak 14" N50°W 1.135
Oak post 12" South .030

1.876
2.837
.288
4.998

Set ¾" pipe
Oak 8" S66°E .505