C.S. # 903

Hardcopy 11-5 # 19

also see notes in file

F. B. 34-32

FIELD BOOK NO. 34, PAGES 32-33

32

908

C.S. 105 con T11S R5W

Set on W. edge of pavement .364 N88°44E of a 3/4" pipe in ditch being N.E. Cor of Abe King's Land thence

10.000 S.21°45'W
Set .494 W. & pat.

15.240
Δ pt. in 65°27½ line with fnc W
Tot 34.868 to ½" p.

19.628 to pt .442 E of pipe
Back to King's S.E. Cor
turn 65°27½ R run W'ly.
5.000
3.653
.044
69°30' int. ang.
5.00
2.471
Δ pt on Cl. line 1.675 E of cor
5.000
3.432
Set .022 N
Δ 114°36' L to line E
3.362
Δ
5.225 to pt .364 W. W pnt

30

In H.C. Lewis & John Stewart Cl's.

Survey for Abe King

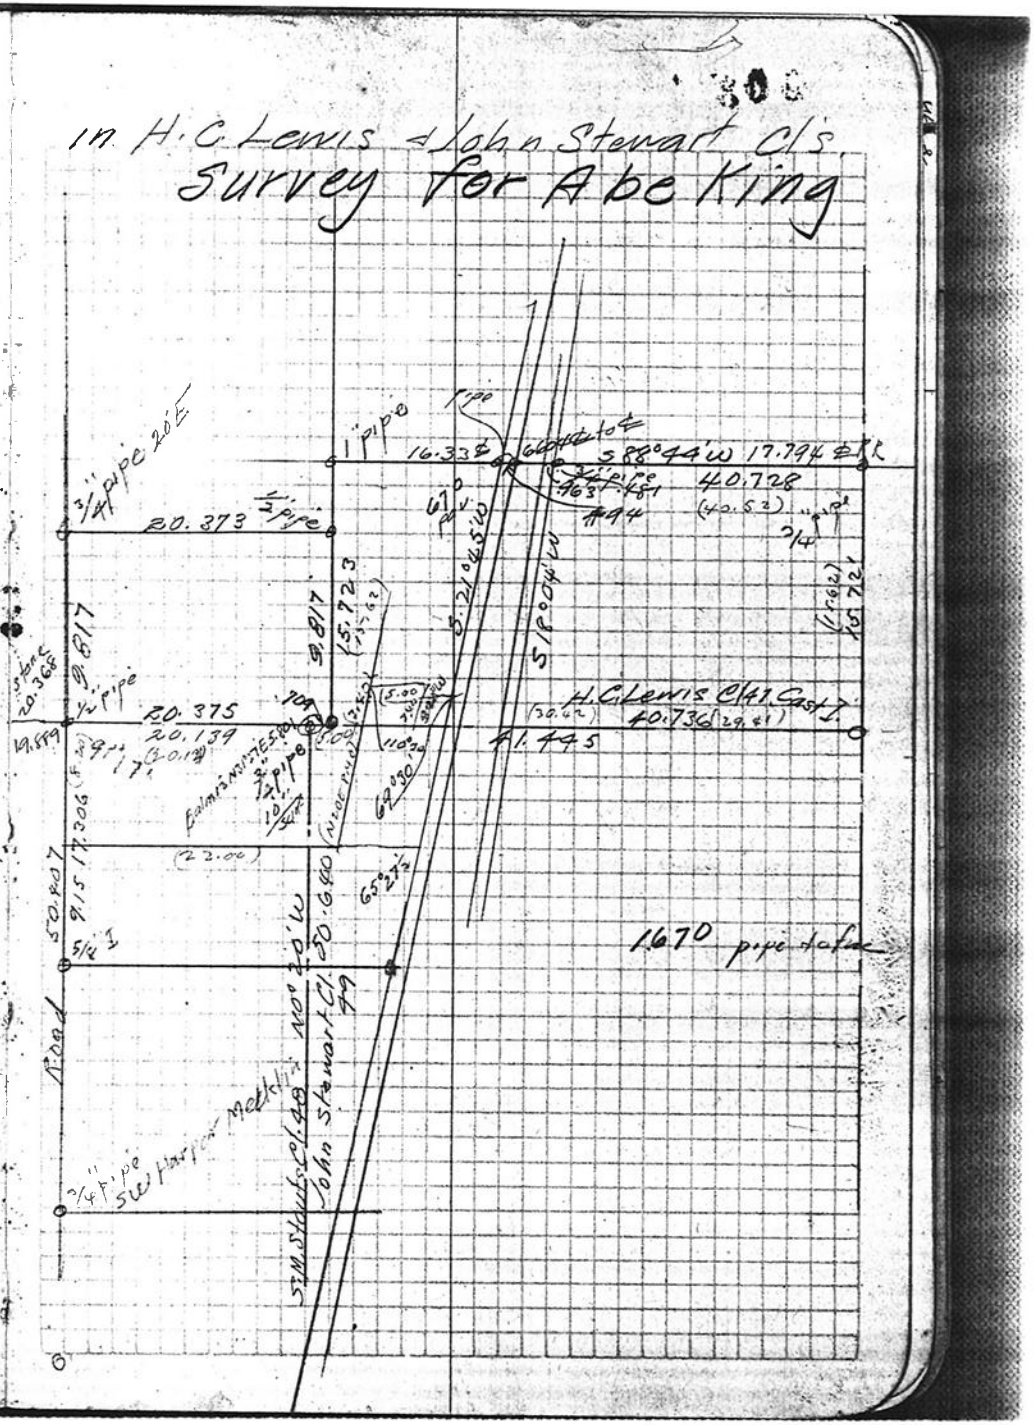

33

65° 16' L

13.660

Δ oak post

5.360 E

Δ W. side pavement

2.046 N to cor N E

Back to pt. ~~near W road~~ S E cor

65° 24' R

~~18.246~~

92° 54' R

Δ .070 S of cor

8.40 − .175 = 8.225

9.652

15.000

2.229
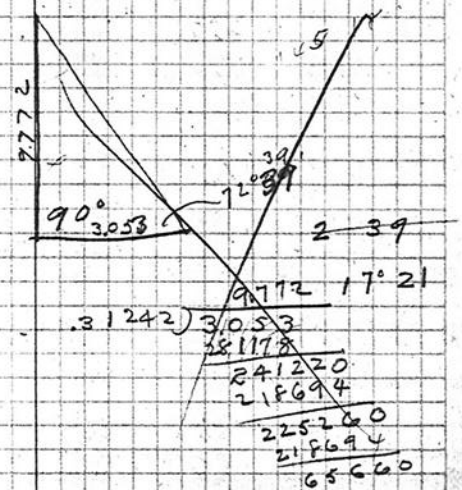
2.6