C.S. # 905

Hardcopy 11-7 #5

also see notes in file

F. B. 34-91

41

T11S C.S. 258-905 F/B # 34 Pg 41

R7W Sec 10 For Forest service

Began at cor. 3/8/10/11 Fir limb s/h all marks + trees

+60 5.000	4.973			.003 N
1.461	1.461			.004 N
-8° 1.647	1.631			.005 N
-17°10' 1.614	1.542			.006 N
-21°30' 1.810	1.647			
		0°37'R		.007 N
-19°42' 2.345	2.208			
		0°37'L	.022 N	.014 S
+3° 2.830	2.826			
		0°19'R		.013 S
+7°40' 4.274	4.237		.0235 N	.0355
		0°19'L	.0235 N in Edge of burn	
+8°05 3.960	3.920			.031 S
		0°19'L		
+11°30' 4.035	3.954			
		0°19'R	.022 S	.007 S
+21°15' 3.206	2.988			.005 S
+12°45' 2.742	2.674			.004 S
+7° 2.865	2.844			.002 S
2.421	2.421			
39.327	39.327			

Correct N. 00 02

△ Fir corner squarely set ¾" iron rod
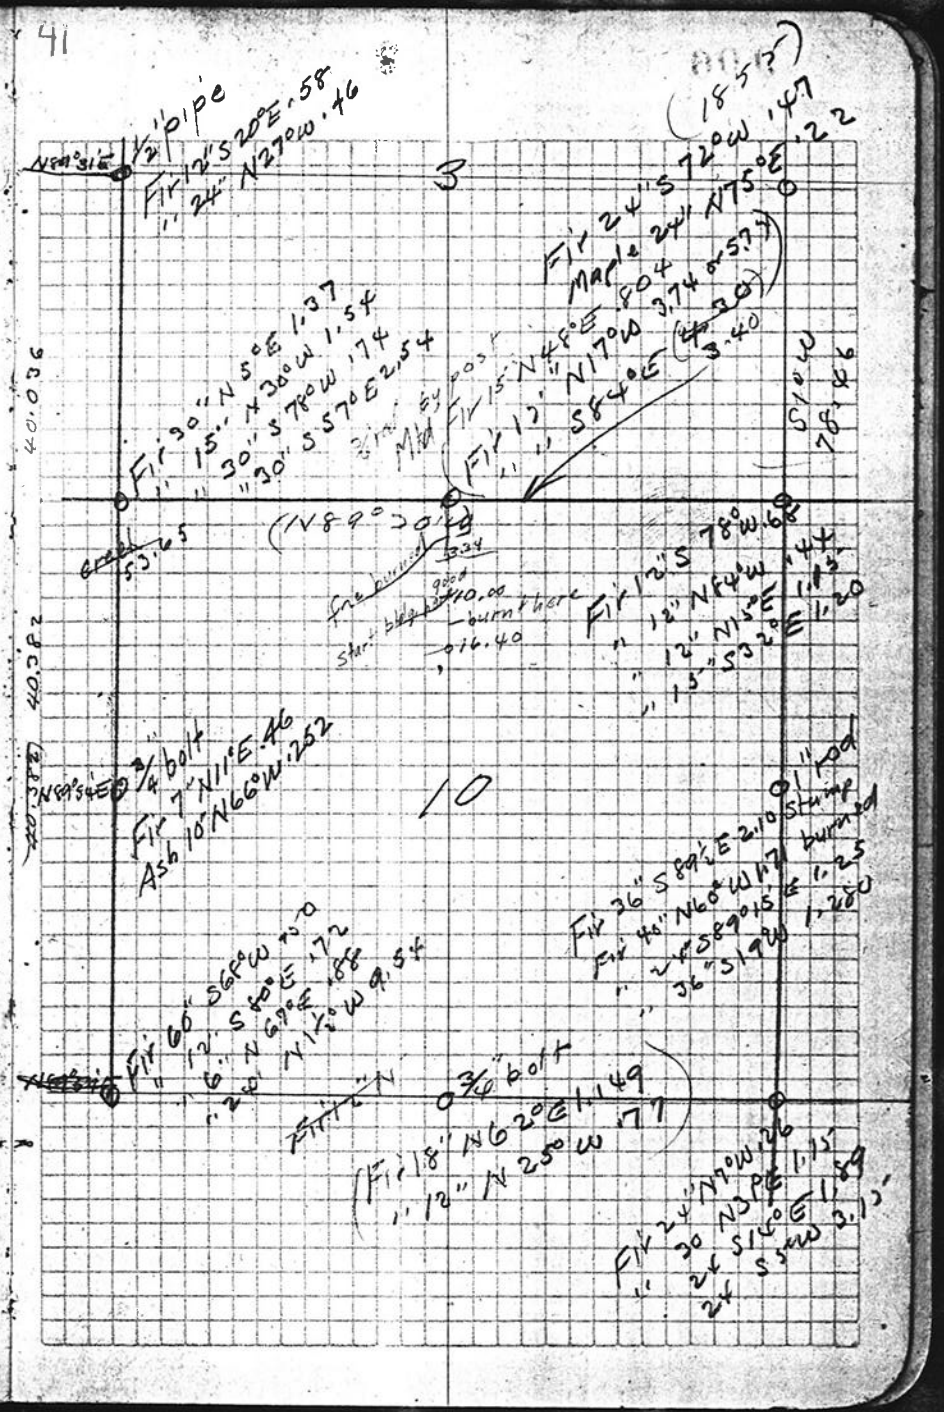
Post in position of orig. fir knot.