C.S. # 906

Hardcopy 13-5 #16

also see notes in file

F. B. 34-42

42 906 : C.S. 2435 Con F/B #34, Pg. 42-43

T13S R5W for N. Newman Heirs

Wiley Winkle Ch. 48

Began at: A

90° ~~R~~ L.

36.875

Δ — .060 fnc.

anchor post .06 E

36.875
.060
36.815

89°47' + 01'
= 89°48'

42.374

Δ 102°11' .06 N of fnc
-.303 +.065 Stone
12"x14"x2"

11.375

93°56'

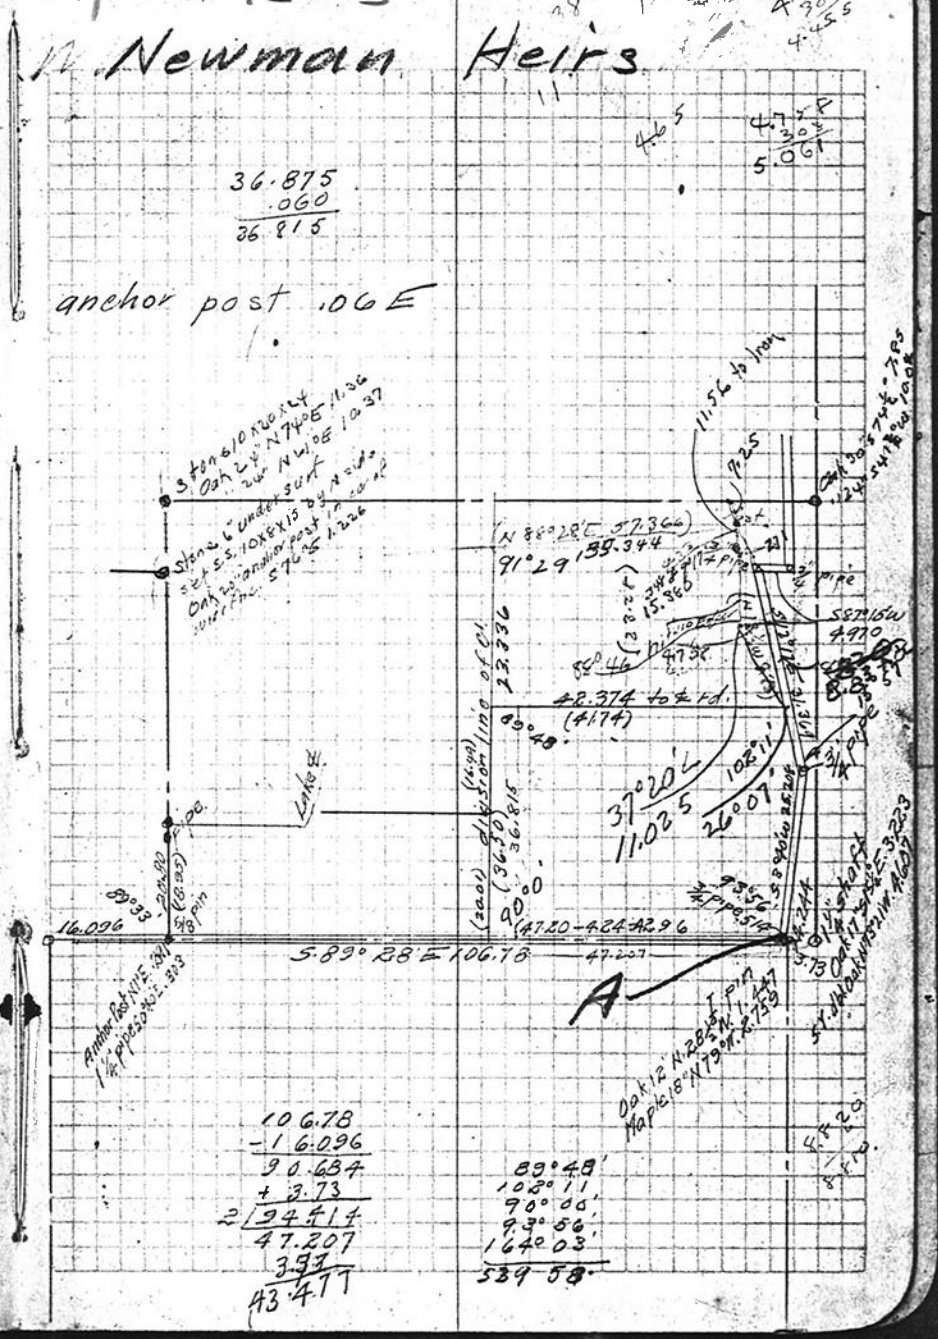
Stone 6' N of C
Oak 24" N 74° E 11.36
2nd N 41° E 10.37
Stone 6' under surf
Set S.S. 10" E 15' by N-S
Oak 20" anchor post 1' N of C
S 76° E 1.226
11.56 ± Iron
P.25
Pipe
Pipe
Pipe

			N	S	E	W	DMD	N	S
.00931	N 0° 32' E	36.815	36.815		.343		.343	12.628	
.01227	S 89° 16' E	42.374		.542	42.374		43.060		23.339
.19906									9.789
.97985	S 11° 29' E	11.315		11.088	2.253		87.687		2.73
.07785						2.022	87.928		2249.382
.99696	S 4° 28' W	85.663		25.585					
.00931	N 89° 28' W	42.96	.40			42.948	42.948	17.179	
			37.215	37.215	44.970	44.970		29.807	3244.994
									29.807
									3215 FT
									160.75
									40.19

36.50
18.438
18.377
32.815
32.500
.315

3650
1649
40.01
18.438
1.572

20.459
1.569
1.331

21.915
21.802
.113
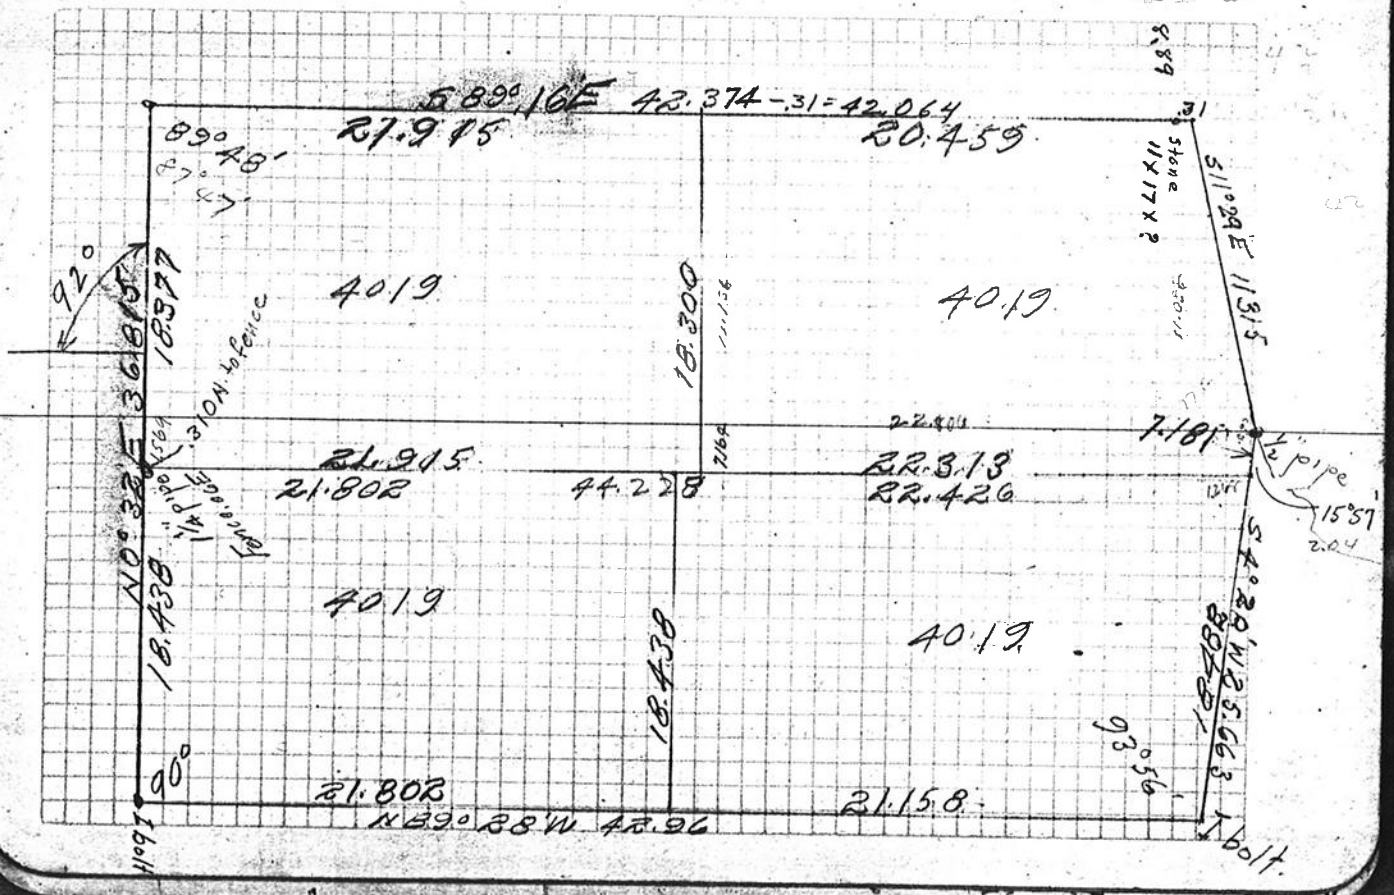
4 | 1.6082
40.21