907

BLOCK 22

COUNTY ADDITION

CITY OF CORVALLIS

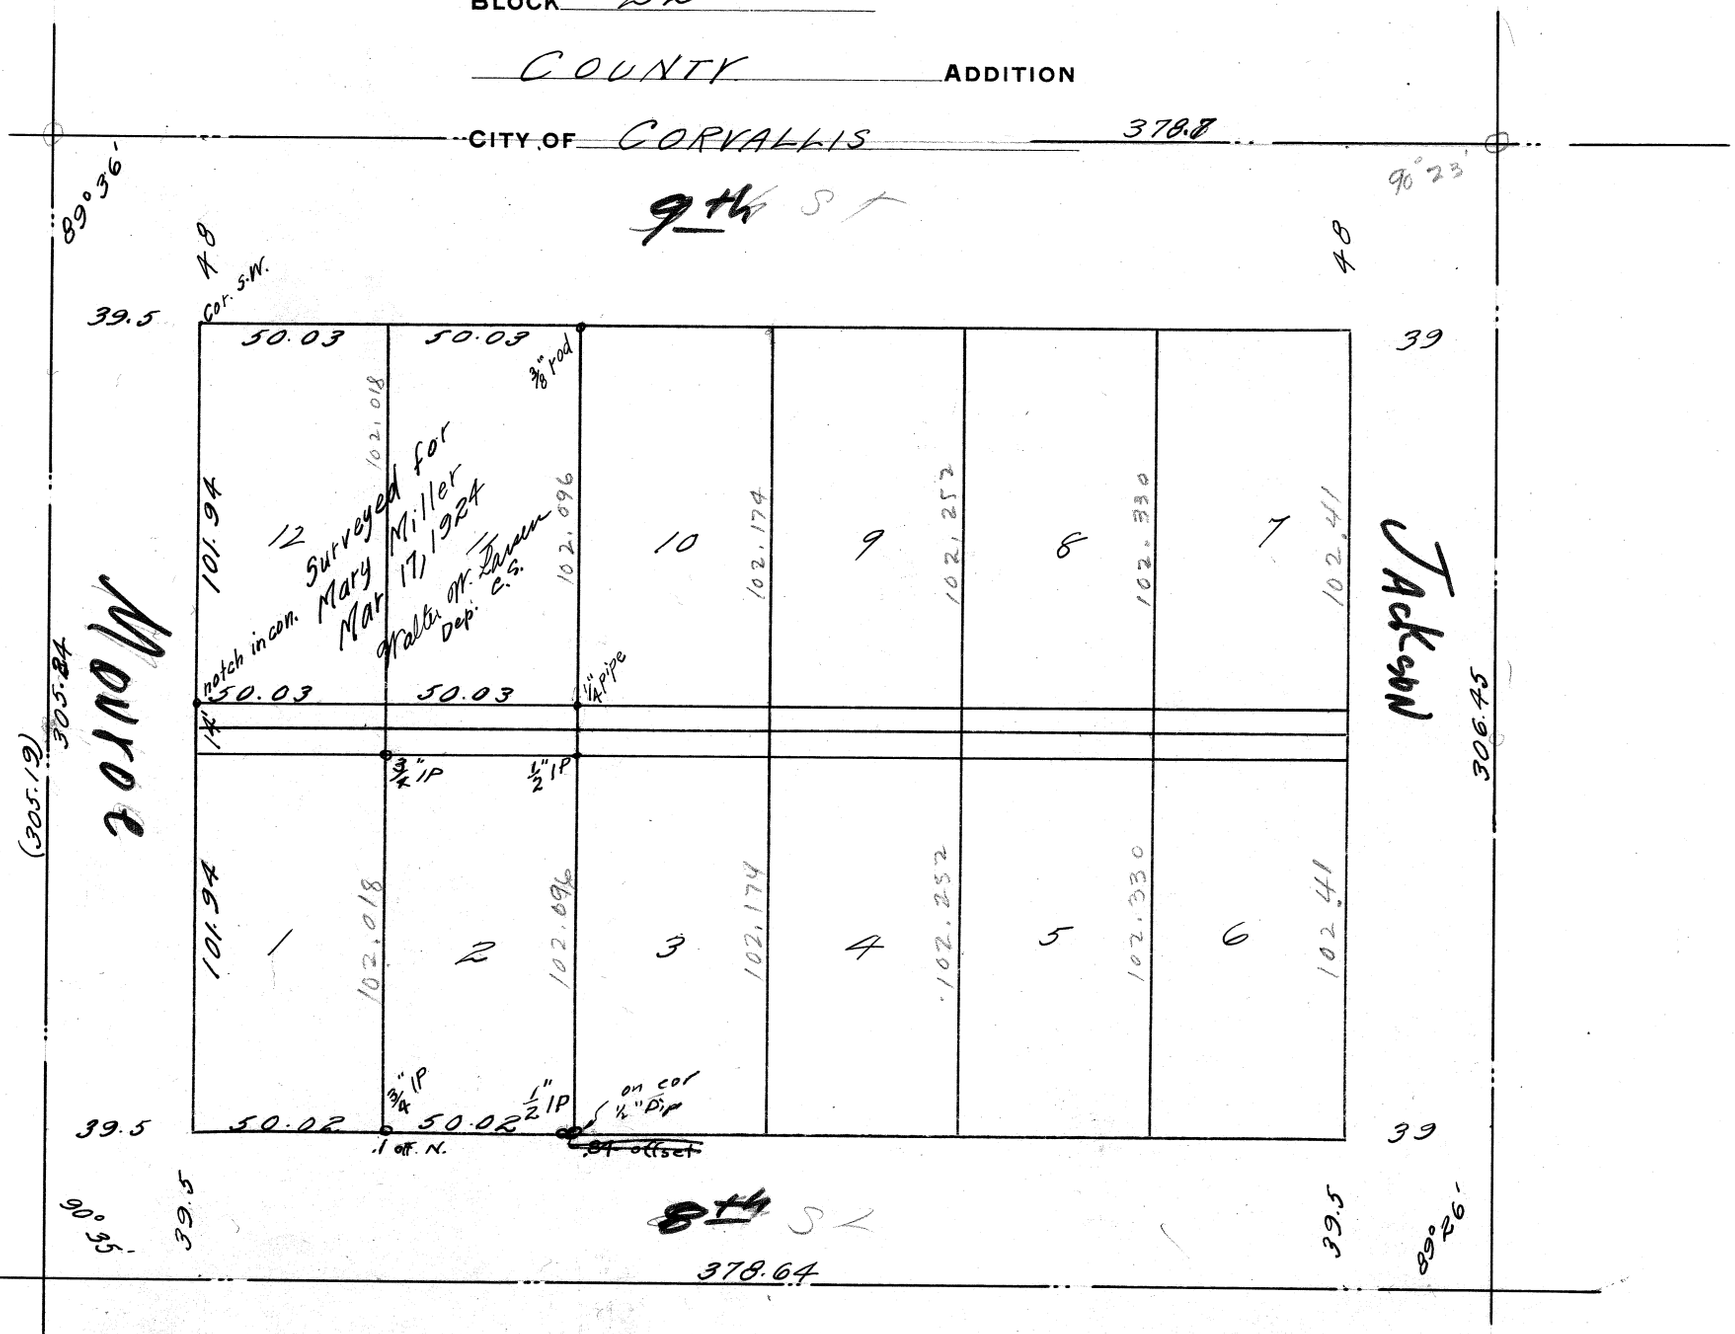

89° 36'
90° 35'
180 11'

306.45
sin. 11' x 378.7 = 121
305.24

378.7
78.5
6|300.2
50.03

305.24
.13
305.37
87.5
2|2|7.87
108.94
7
101.94

378.64
78.5
6|300.14
50.02