C.S. # 913

Dixon's Addition

Block 2

Lot 8

F.B. 31-28

28

FB#31

6 | 300.44
50.07

115

50.22
6 | 301.34
30
18
12
14

50.22
50.07
.15

June 1924 by W.C.G.
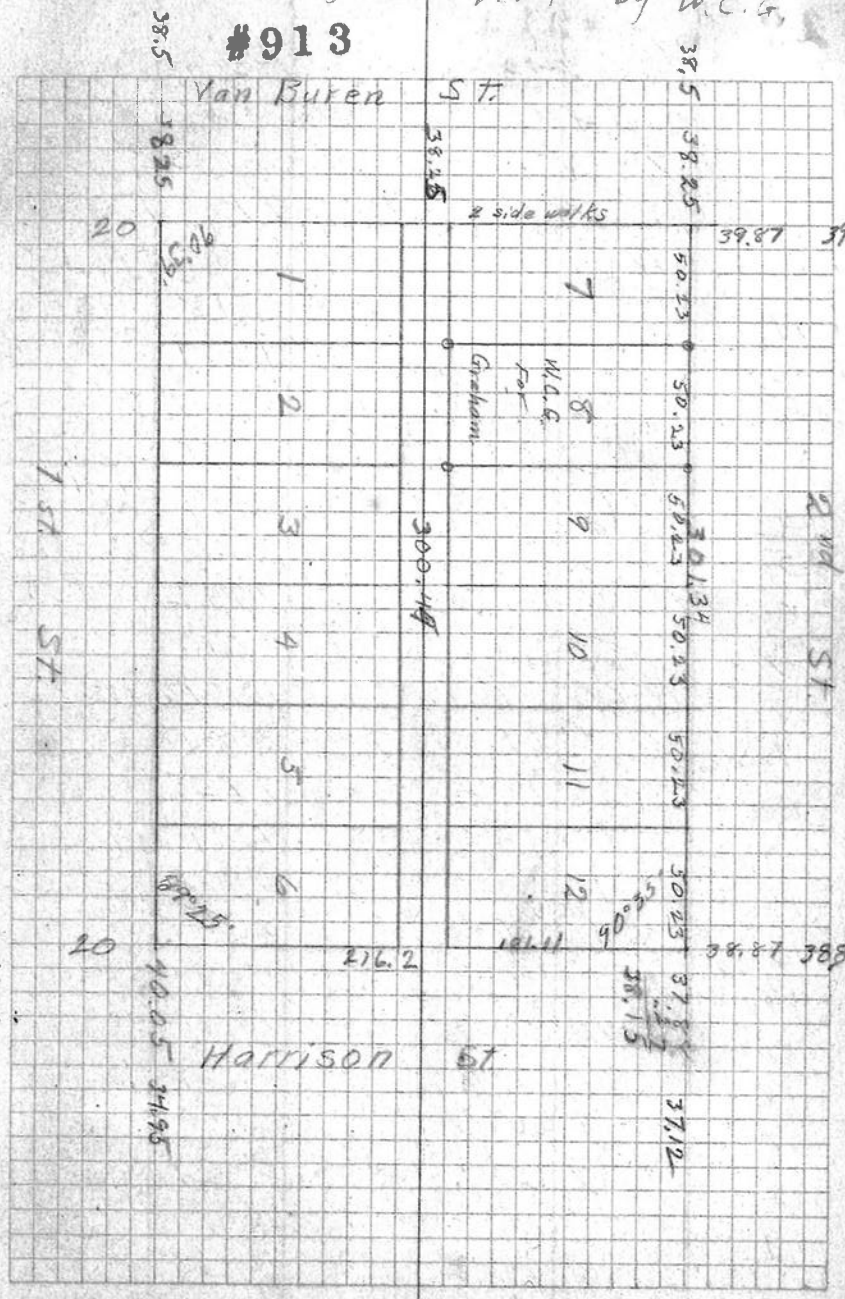
#913