917

BLOCK 4

Wilkins ADDITION

CITY OF Corvallis
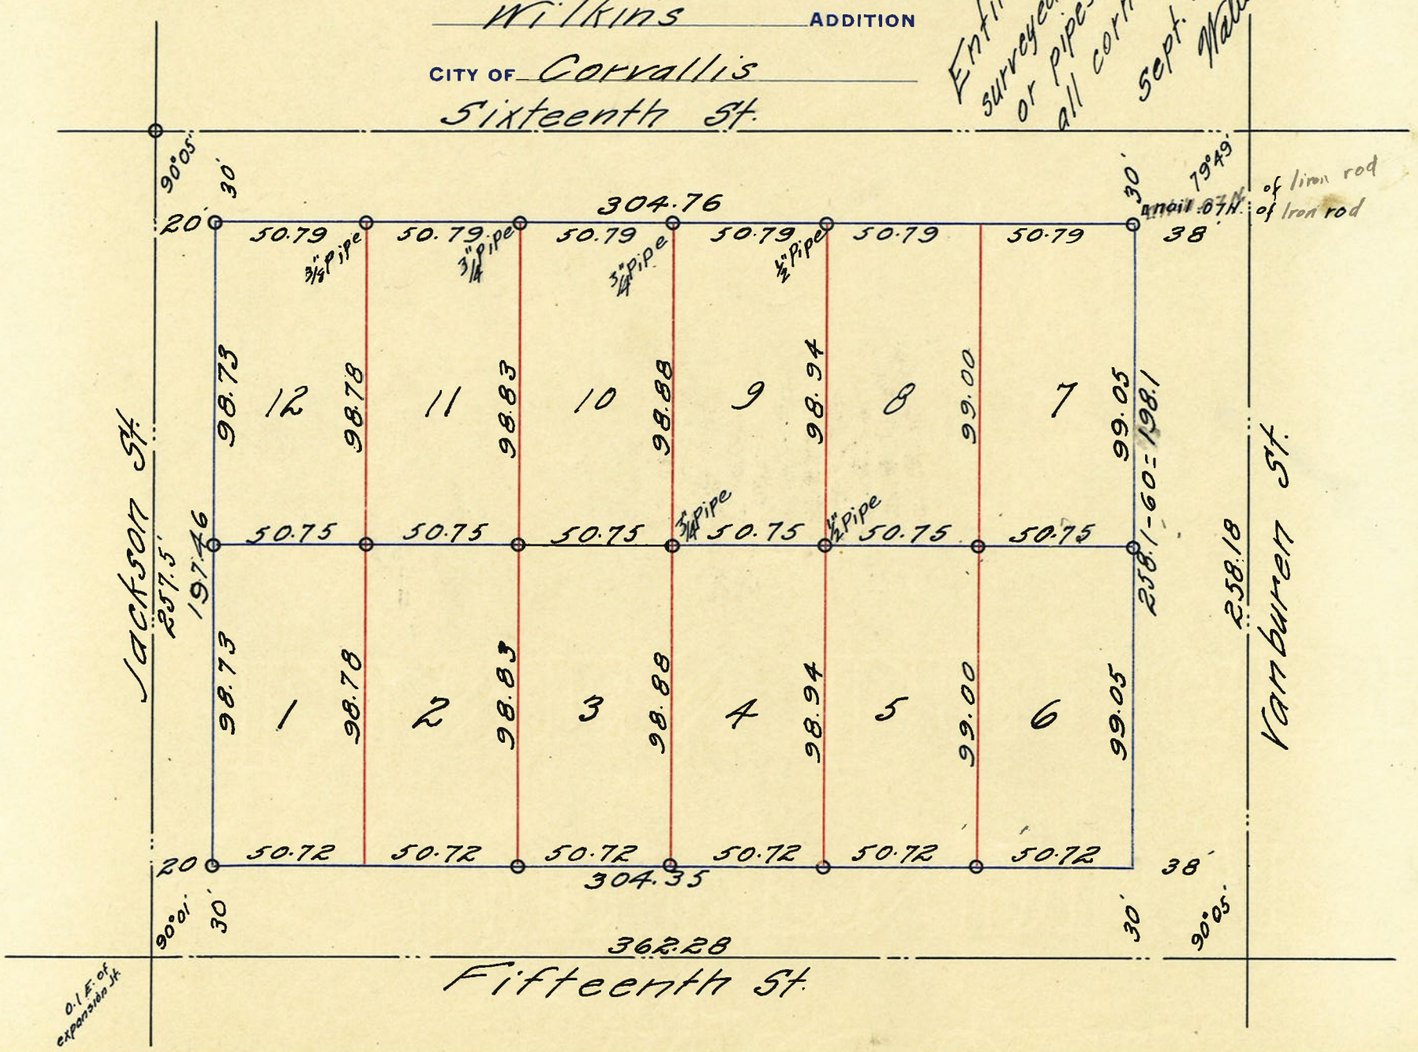
Entire Block surveyed and irons or pipes set at all corners marked ⊙. Sept. 15, 1924 Walter M. Lauer