C.S. # 919

Hardcopy 13-5 #16

also see notes in file

F. B. 34-44

44

919

T. 13 S. R. 5 W. FB#34.

Hubbard

Sept. 18, 1924

Began at a 1" rod in a stone, the S.E. corner of Cl. 47. Backsight ~~Foresight~~ on pipe South 89° 20' L

40.00	40.00	set 54 l S. To Cl. line pipe
Δ		+.60 on brush edge
2.480	2.48	
Δ		on E edge of lake
5.000	4.968	- 6° 31'
2.737	2.677	+ 12° 0'
1.532	1.532	N. 89° 0' W
14.454	14.454	correct 5.47'
8.174	8.174	= N 89° 47' W
~~10.000~~	~~10.000~~	
7.546	7.546	
	81.831	
	+ 1.664	and striking N. at N.W. cor. 1130
	83.495	91° 13' L
	.01353 = 46½'	
83.495	1.13 = 0°	

85° 30' int ang to R.R. N 5° 30' E.

5 30'

91° 00'

85° 01' L int. ang. R.R. and Winkle S. line = S. 84° 29 E.

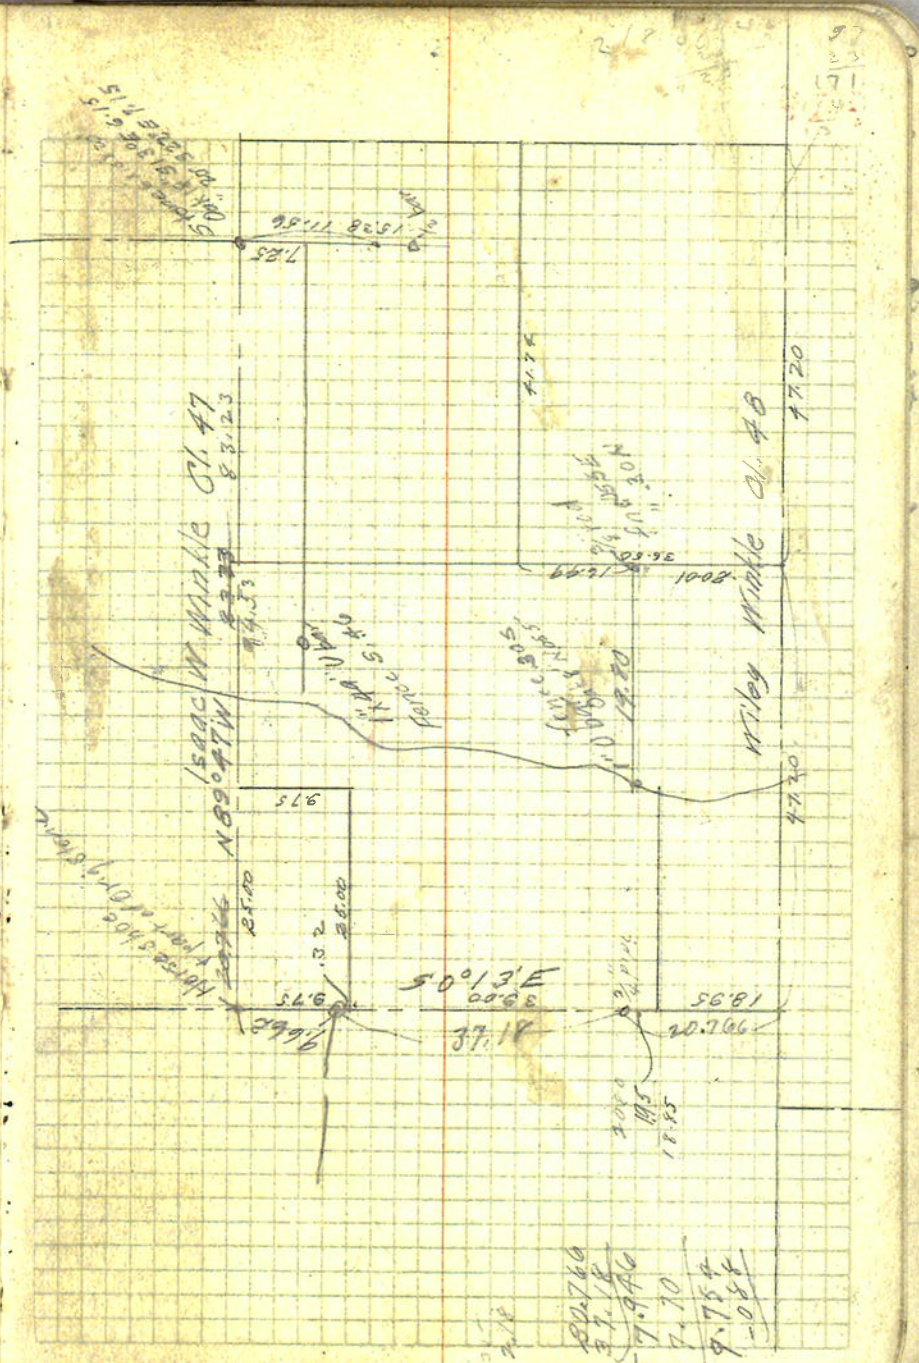

Set on pt. 40.00 N89°W of SE cor. cl. 47 turn 90°R. 7.791 set U bar.

7.25° S. of claim line

79°42' R
S80°42'W
3.052

6°31' R
S89°13'W
3.738

0°07 R
S89°20'W
4.700
1.341

78°41' L
S10°39'W
4.560

12°19' L 109°R N52°21'W 2.50 bank of lake
4.700

S1°40'E
3.524

.66 W to lake
1.50 cross pt of slough
4.700
2.620

31°04'R 79°R S37°20W 3.92 bank Lake
4.70
4.70

S29°24'W
3.555

55°19' L 110°R N40°36'W 2.92
4.70

S25°55'E
462

1°22' R
S24°38'E
4.30

64°51' L
S89°24'E = S89°28E
1.00 W to lake

3.52 wide S3°20'W 5°R 1.65 to pt of intersection on ranke S20°40 E or 28°30' E down 2 links

60°R N70°36'W 2.27 35½°L S64°54'W 4.30 wide 2.00

.10 R to edge of lake 1.00 wide