C.S. # 920

Hardcopy 14-5 #27

also see notes in file

F. B. 34-46

46 920 FB#34. C.S. 12 1240

for Harpole Sept. 26, 1924

Sec. 25, T. 14 S. R. 5W.

Began at sec. cor. 26/25 35/36

Run East Mag.

S 89° 54' E

.654

Tot ang 90° 30' R

N 0° 36' E

5.045 86° 25' R

N 86° 51' E

5.000 correct 0° 26½' S. = (N 87 17 E)

1° 03' R

N 87 54 E

~~5.005~~

4.981

3.165

~~5.005~~

Total 24.75

Tot. 0° 32' L

4.822

1.123

N 86° 19' E

30° 19' L

N 56° 0' E

3.573

Tot 37° 31' L

N 48 48 E

4.275

Tot 43° 53' L

.655

0° 0' N 55 E

.252

Set ¾ rod

33° L 160

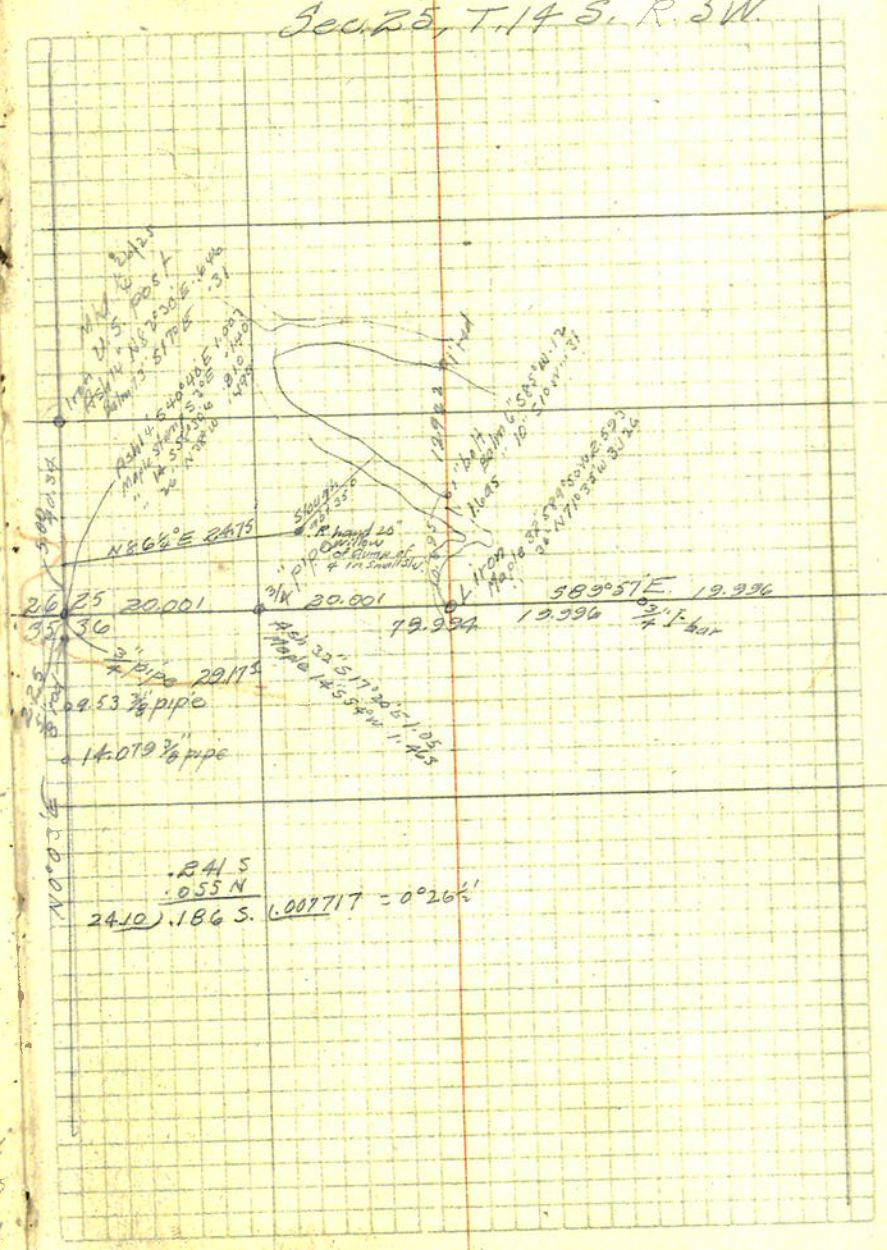

47

Back to ℄
122° 04' R
4.960 S53° 01' E
△ 16° 20' R 1.30 L to bank
2.23 S36° 41' E
△ 27° 50' R 1.30 L to bank
3.91 S8° 51' E
△ 18° 27' R
3.80 S9° 30' W
△ 26° 32' L
3.837 S17° 02' E
72° 59' L
2.397 N89° 59' E
ang 105 89° 40' L to stake X,

83° 34' L S0° 07' E
corrected 0° 42' = S0° 05' W
83° 34' R 65 ft.
90° L .35 L
0° 37' R
93° 12' L to line Ely
from pt 5.4' L = .082 L

hit .133 E of pt

N86° 11' E
.654
.133
.787 (0.34)

E .650
W .352
E .298
W .787 0° 42'
W .489 (.01212

.133
.082
5.045) .051 (.01)0109 = 0° 35'