C.S. # 922

Hardcopy City Plat #9

also see notes in file

F. B. 31-35

35

FB #31

Block 1 Avery's Addition

#922

2 | 203.88
101.94
20
7
125.94
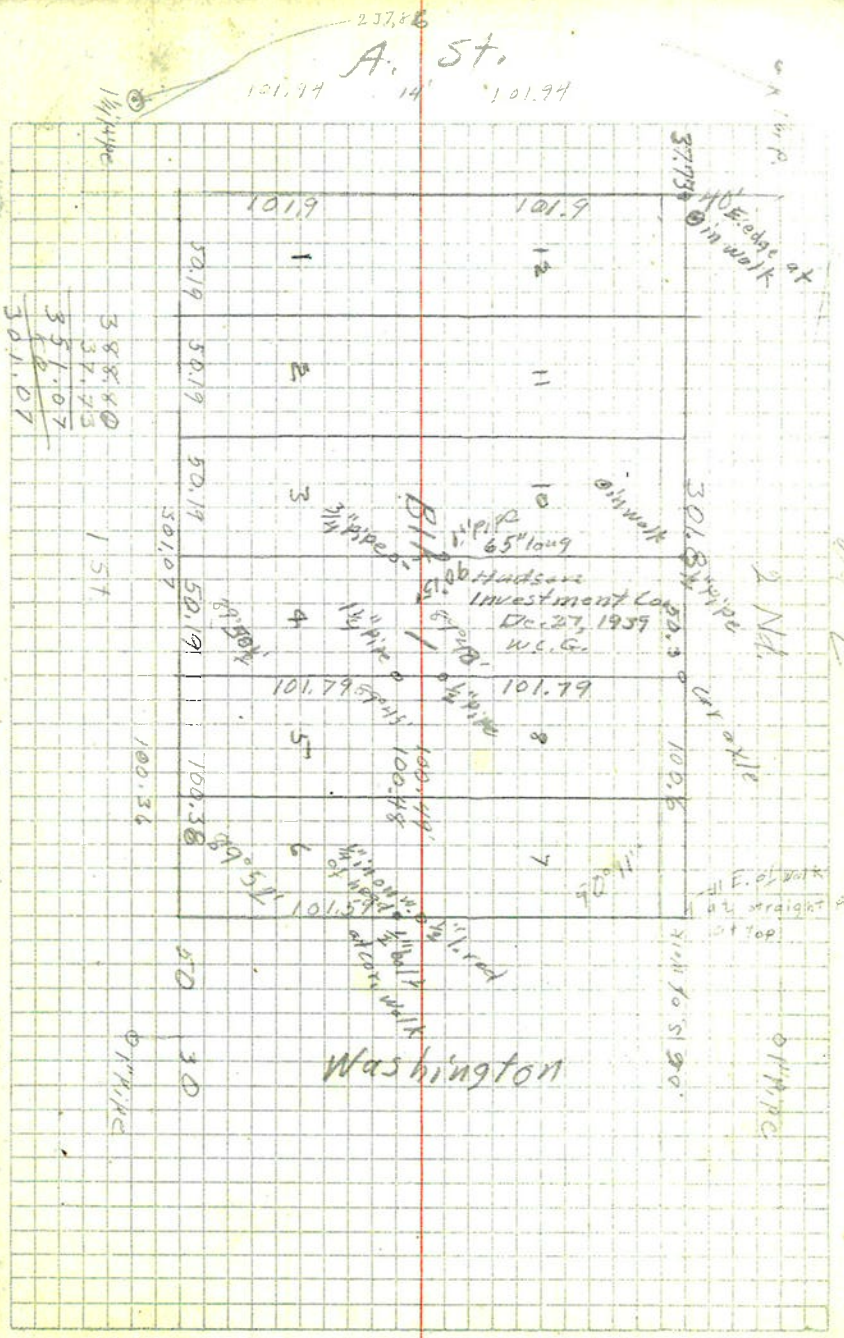
237.18
20
237.18
14
2 | 203.18
101.59