926

BLOCK 23

Marysville ADDITION
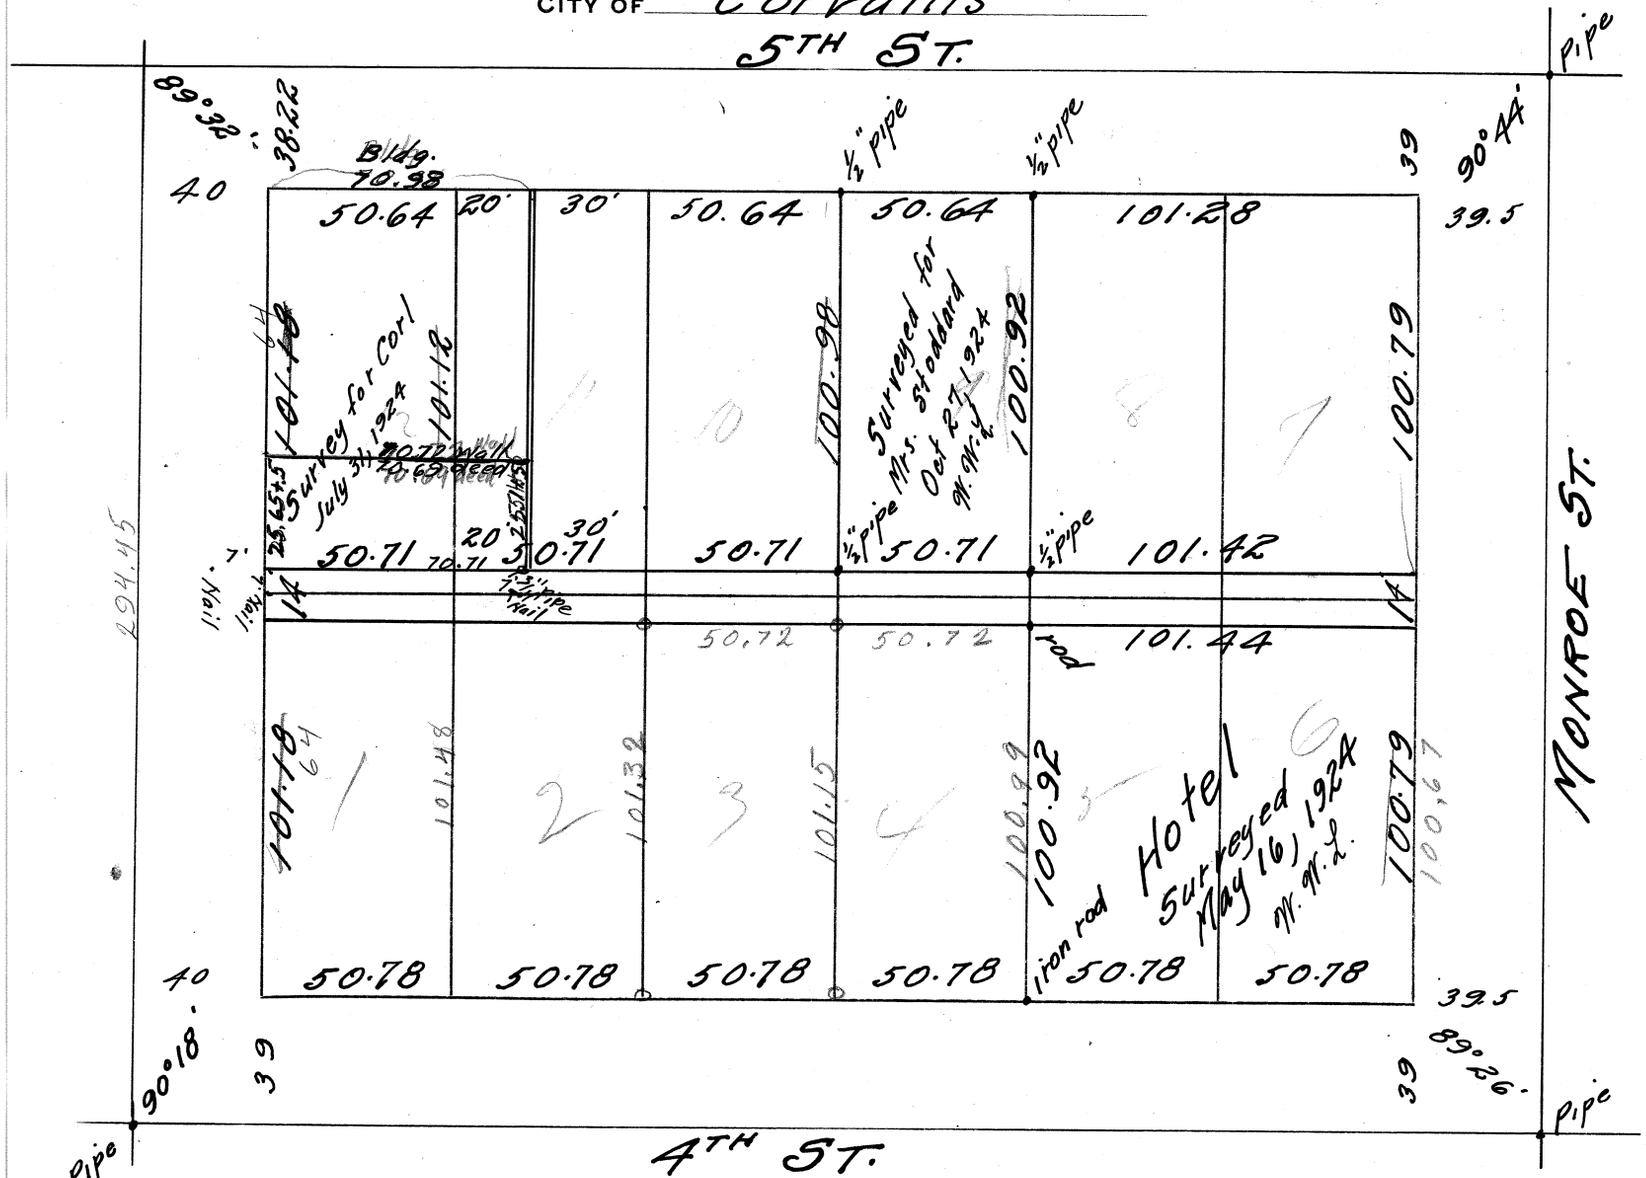
CITY OF Corvallis