C.S. # 927

Hardcopy 11-5 #1

also see notes in file

F. B. 34-59

COUNTY SURVEY NO. 927, FIELD BOOK NO. 34, PAGES 59, 60

59

927

Survey No 81 cont for Chas Akmstrong Nov 12, 1924

Beganat NE. cor A. Fuller cl. 38

W

4.891 4.780

4.946 4.912

2.997 2.967

.781

13.440 + .066 = 13.506

89° 42' R

3.105 3.095

.898 .891 = 3.986 N 0° 18' W

90° 18' R

E

4.344 4.270

5.664

5.000

1.858 1.854

11.124

5.000 4.957

1.720 1.720

1.202 1.147

5.000 4.945

5.000 5.000

1.970 1.970

to mile

19.789

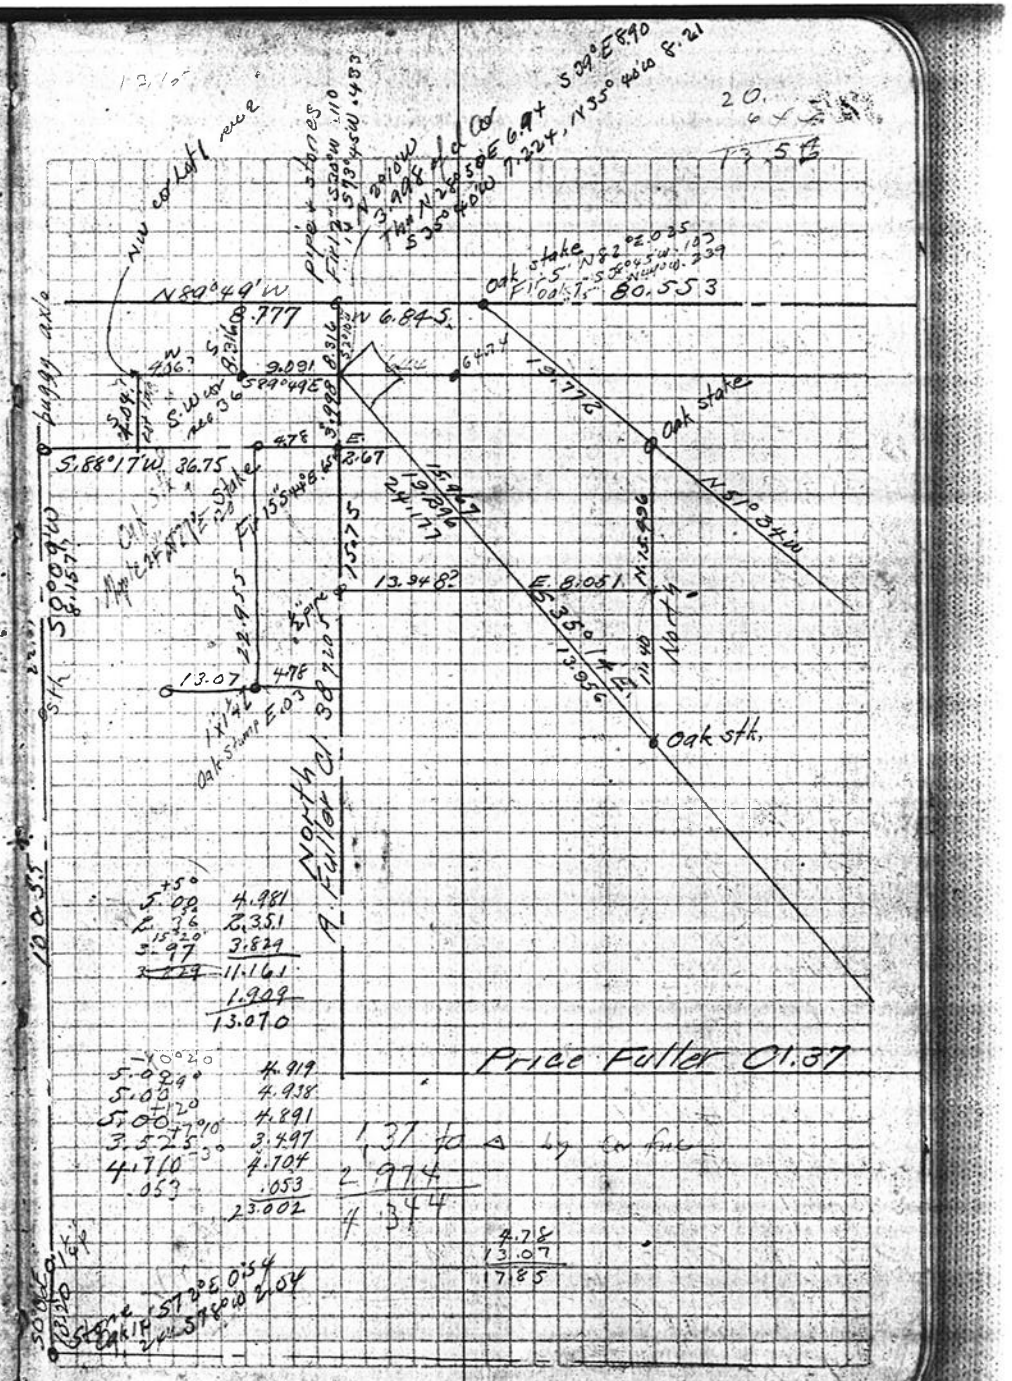

60

+6°
3.105 3.088
+15°05'
2.735 2.641
+14°
1.008 .978
+2°
2.075 2.074
8.781

90°11'L

-3°
2.188 2.185
-10°15'
4.350 4.280
6.465
8.394
0°18'L

-9°50'
1.958 1.929

90°18'R

+10°45'
4.473 4.395

West
90°L

-9°30'
2.587 2.551
2.234 2.222
4.773

91°54'L Down Chain
0.066 to hub set to

Back to NE cor 01 37
S.

-5°45'
5.000 4.979
-7°
5.000 4.963
+3°
3.067 3.065
-6°
2.660 2.645
15.682

+54'
92°23'L 91°L

+3°
1578

2788
4.928
4.950
3.076
15.742

Set 3/4" pipe
Fir 34" N74°E .22'

0°15'
1578
5°00
3720
3.005
14.103
14'
53°
.327
90°