C.S. # 930

Hardcopy 11-4 #15

also see notes in file

F. B. 34-61

61 C.S. No 882 F/B 34, PG. 61-62

Survey For Christ. Kendall Cl. 48 T11S R4W

930 C.S. 930 Dec 4, 1924

Began at ¼"x1¼" bar 3.345 most E.N.E.
N89° 26'E of stone ∧ in W. cor Cl. 49
Turn 90°15'L
10.00
2.547 +00 sta. N0°49'W △ ¾" pipe .033 E
2.656 ℄ 30" Sta. N W and O
-.30 sta correct E 0°09'
+11°15' = N0°40'W
.880 to bank
4.840
△ hit .054 W. of 1½" pipe
Back to Beg. run
N89° 26'E
8.750
△ 90°06'L
2.586 2.586
-4°30' 1.084
1.087 1.130
1.130 90°06'R Set 1¼" pipe
0
4.145
4.740

10.394
5.382
.970
△ Set 1" U bar 4's of bank
+.50 N ℄ slough

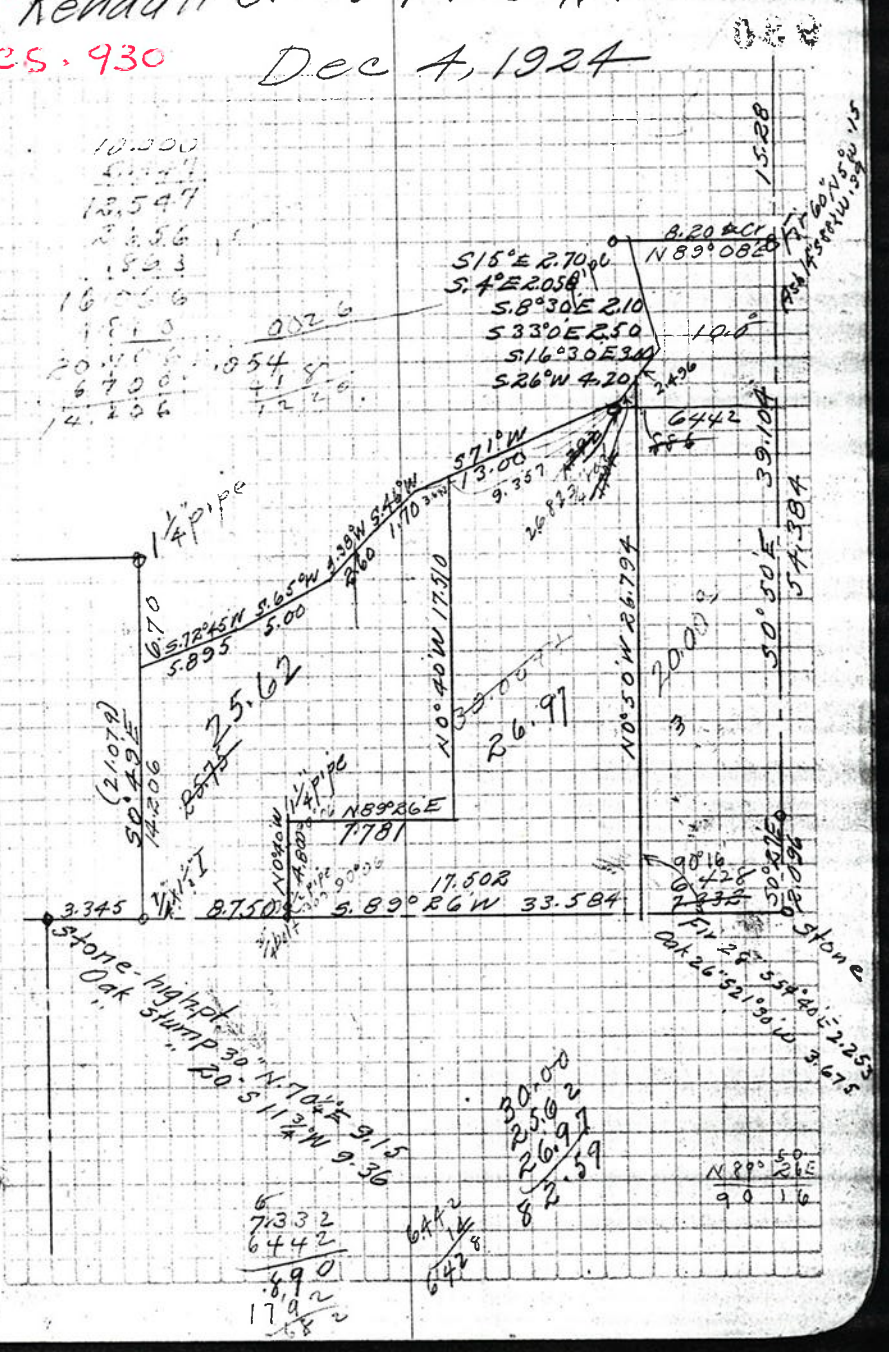

62

Back to S.E Kendall Ch

Run S 89°26'W 7.332

N 0°50'W 303 set 1¼" pipe

25.00

D

4.975

90° R

3.226

90° L

5.005

5.000

1.104

87°15' R

1.601

6ft N of car.

Back to D B.S. S.

106° L down ≤ slough

90° 2.90 ≤ Slough at 3.00 90° 1.00 ≤ S/

90° 1.00 ≤ S/

90° L 4.15 ≤ S/

90° L 4.30 ≤ S/

1792 Left turned on back 290° slough

890 Right to pipe

4975

-323 = 0.92

-323 = 1.07

25