C.S. # 934

Hardcopy 12-6 # 26

also see notes in file

F. B. 34-66

66

934

FB# 34 C.S. 71

T. 12-6 Sec 20

School Lot on R.O. Watkins

(5.00 - 1.803) From ℄ Rd + Rt ang

90° R

2.773

Back to Road

3.104 N to ½" pipe on W of Road

69° 43' L int ang fro

3160

Δ

R4° 28' L
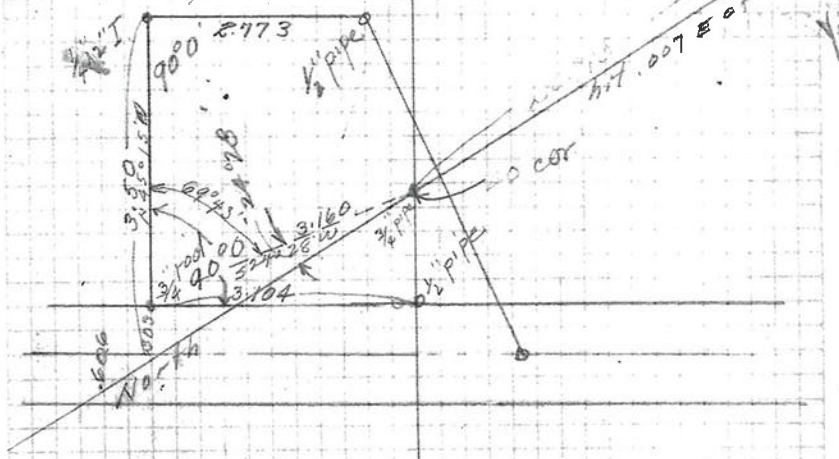
Alt .007 E of cor.