C.S. #936

See notes in file

F.B. 31-54

54 FB #31 #936

C.S. Road 488 Up Lobster Valley

Beginning at a Gun bbl. the ¼ Cen. of Sec 5. T. 15 S. R. 8 W. W.M.

From Gun bbl.	A 36" snag	S. 67° W.	28.5'	Slope −11°
1	S. 55° 40' E.		447.5	
2		−17° 13'	135.6	= 129.5
	Axe N. 25° E	42.7		
	Road Stake #283	N. 45° 45' E.	-16.6'	
3	S. 69° 38' E.	0.0	595.0'	
			149.0	Beginning of Road 488
△1 of Road	Thence N. 69° 35' W.		149.00	to △ 3
2	S. 4° 18' E.	−11° 15'	1.676	= 1644
3	N. 67° 24' E.		732.0	E 8.0.9
4	S. 82° 03' E.	−1° 24'	300.9	E 3' = 300.6
5	N 80° E.		424.8	E 10 =
6	N. 61° 13' E.	+1° 30'	500	= 499.8
		+1° 30'	351.0	= 350.9
From △6	S 30° 27' W.	−3°	499.9	Side shot To ¼ 514 = 499.3
			5000	
		+3°	445.6	= 445.0
7			−16.4	E 20'
	S. 88° 12' E.	−1° 25'	500.0'	= +99.9 E 2 or 3
8			110.8	
9	N 80° 41' E.		292.1	E 1
10	S. 74° 31' E.	+1° 50'	202.5	1 to 15' = 202.4

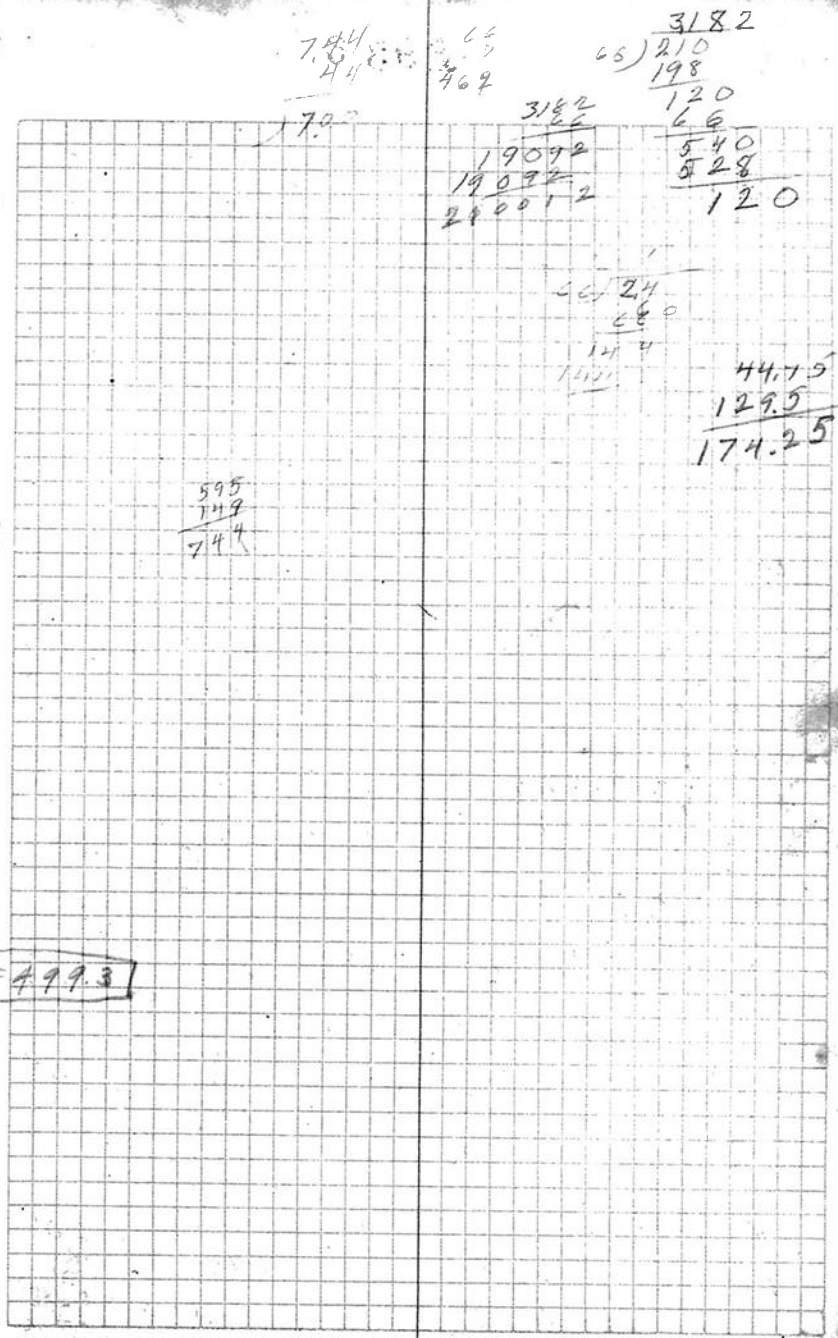

55

11	S. 86° 30' E.			426.C	E. 2
12	N S 1° 17' E.			334.4'	E 3'
13	S. 73° 56' E.		+2°20'	174.0	20' E. of School lot
14	S 31° 41' E.			303.8'	E 5'
15	S. 53° 42' E.			362.4	
16				371.2 = 734.0	
17			-1°10'	224.9	E 15'
	S. 26° 46' E.		-1°25'	500.0 = 499.8	
18				299.9	E 2 to 3'
	S. 36° 27' E.		0.0	500	
19				237.5	E 2' to -
20	S. 21° 14' E.			246.4	E 2'
21	S. 31° 08'' E			265.4	E 3' to 4'
22	S. 4° 44' E.		+2°05'	278.0 = 277.8	E 5' to 6'
23	S 31° 37' E			243.6'	E-3'
24	S. 2° 30' E		+P20'	165.25 = 165.2	
25				156.6	T=100'
26	S. 48° 38'' E.		-1°35' 45'	426.6 = 426.4 E. 3'	
	S. 30° 56'' E		+2°	500	=499.7
27			+3°10'	91.5	=91.4 E. 20' to 22'
28 Pg	S. 17° 20' E.		+1°40'	101.7	=101.7
29				850.9	
30				25.7	E 20'
31	S. 19° 15' W.			194.0	E 5.0'
32	S. 15° 05' E.		+1°55'	283.1 = 283.8	E 5.-

S. 77°14' W. To △ 5 = chart
S. 77°28' W. To △ 4
S 61°28' W. S.W. cor. School lot.
E. 5/8'
= 173.7

N 32°20' E 83.8' To 4/3 9/10

56

33	S. 20°12' W.	+2°	112.9	= 112.8	
34			210.5	E 5'	
34	S 43°39' W.	-1°30'	348.7	= 348.6	
»	S. 86°54' W.	-2°	244.6	= 244.5	
¼ sec. cor.	N. 61°16' W.	-5°	352.6	= 351.1	

S 43° 39' W. 348.6
50° 38½ 133.6
94 17½ 215.0
150
N 85° 42½ W.

653.14' +.31 = 653.45
112.8
210.5
323.3

At 133.6 x 99.9 = 233.5 L R. 50° 38½' along Co. Line N. 85° 42½' W.
is County line
700.4 East of ¼ sec. bet. 9 & 10.

N 66° 06' W.
- 4° 40' 360.0 = 358.80 to ¼ cor. in 1943.

86° 37½
85° 42½
550