C.S. # 939

Hardcopy 14-5 # 25

also see notes in file

F. B. 31-57

57

F/B 31, Pg. 57

#939

C.S. 242

For Wm. Carpenter

T14-5

Mar. 2, 1925

Tolly Place
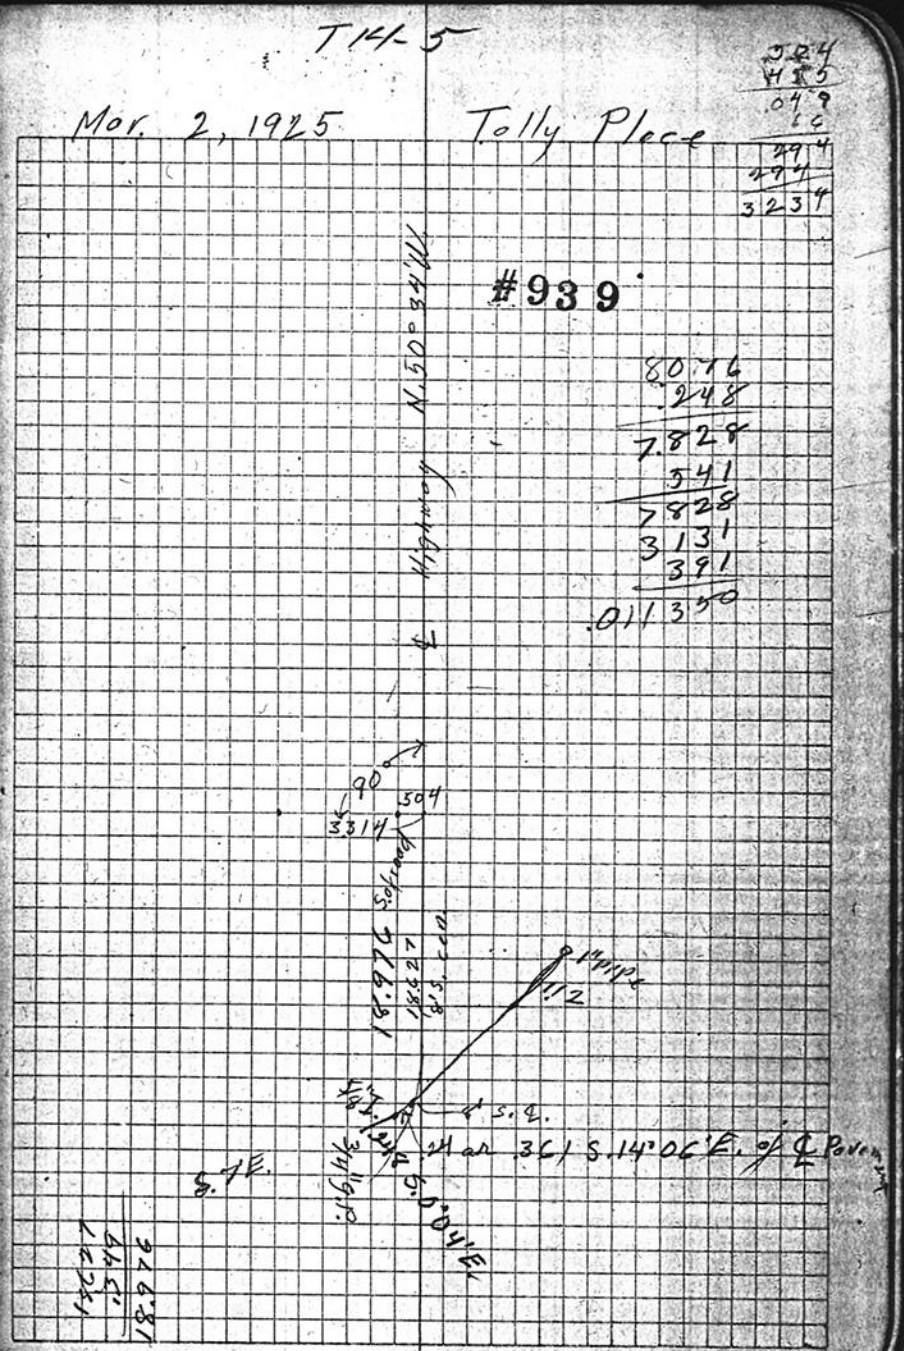
#939