C.S. #941

Dixon's 2nd Add.

Block 13

F.B. 31-59

59

CS. #941

F/B

31, PG. 59
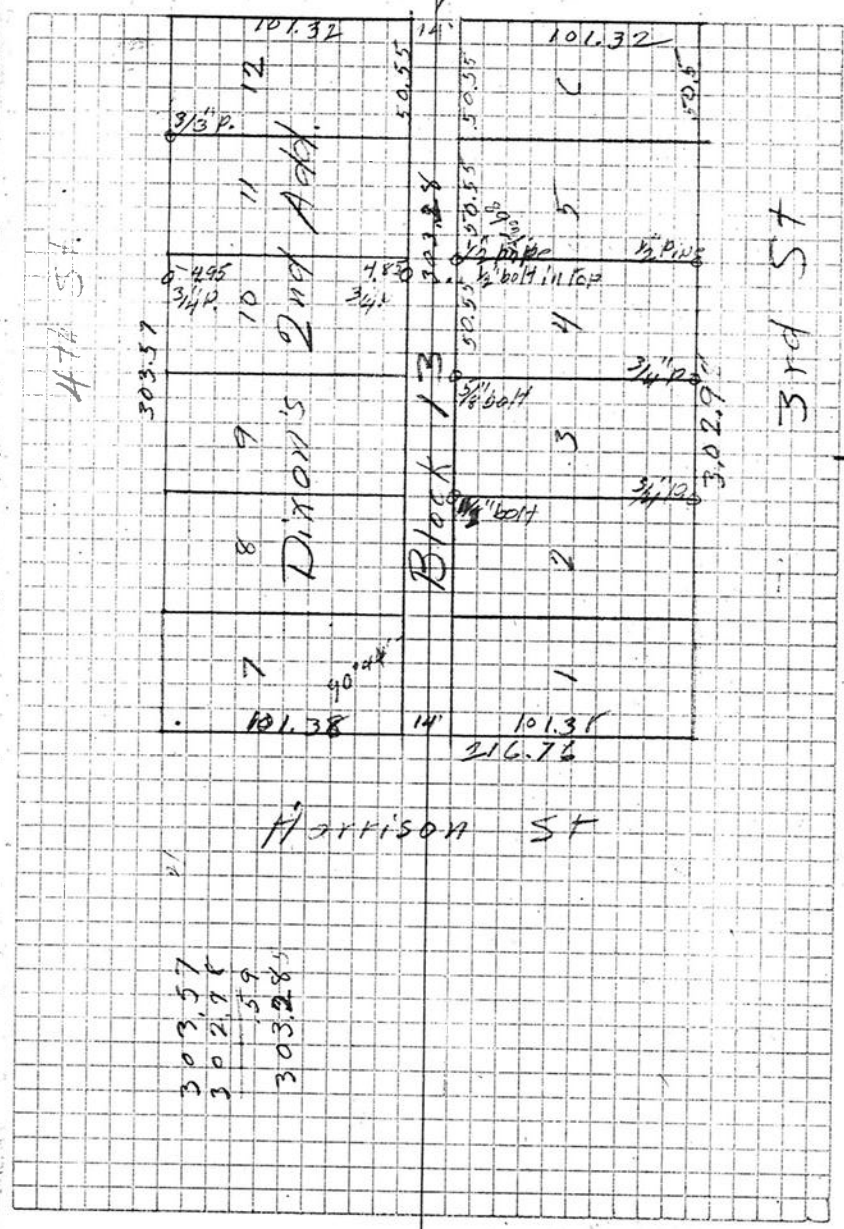
Tyler St.