C.S. #943

in Toledo, Lincoln Co.

F.B. 31-61

31

MINING

TRANSIT BOOK

363

61

Union Oil Co.

Toledo

#948

10.50
3.84
6.66
4.07
10.73

N. 84° 45' W. 539

6.66 Elev. of M29
10.6
17.26

N. 12° 05' E. 207.15

H.H. Harris dirt fill

℄ Hwy.

N. 77° 55' W. 20 C

62

Elevs from Depot at Toledo
To Union Oil land

B.S.	H.I.	F.S.	Elev.	
3.92			16.0	on Rail at depot.
	19.92			
3.87		4.00	15.92	on rail
	19.79			
2.77		4.97	14.82	
	17.59			
			2.94	Top S. Rail
			7.3	S. rail Spur Switch & Hwy.
			6.0	N of N.E. cor. of Tract
			2.8	S rail N. of N.W. cor.
			5.9	S. rail on spurr in Hwy.
			2.8	
(10.59) 4.03		11.12	6.47	on Top N.W. Cor. of Tract
	10.50			
10.59				
	17.06			

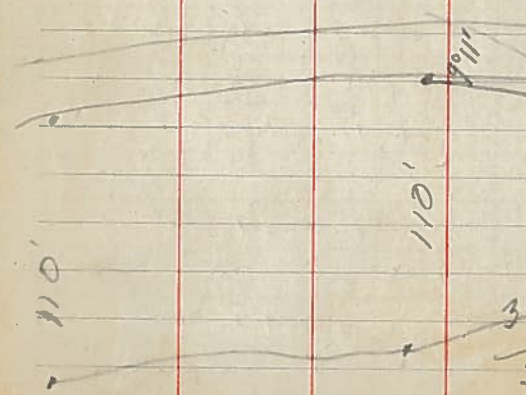

4.5-14.6
4.5-12.6
4.5-12.6
4.5-11.8
5.0-12.1
10.7-6.4
11-6.1
10.1-6.4
10.1-6.9
N.W. Cor

63

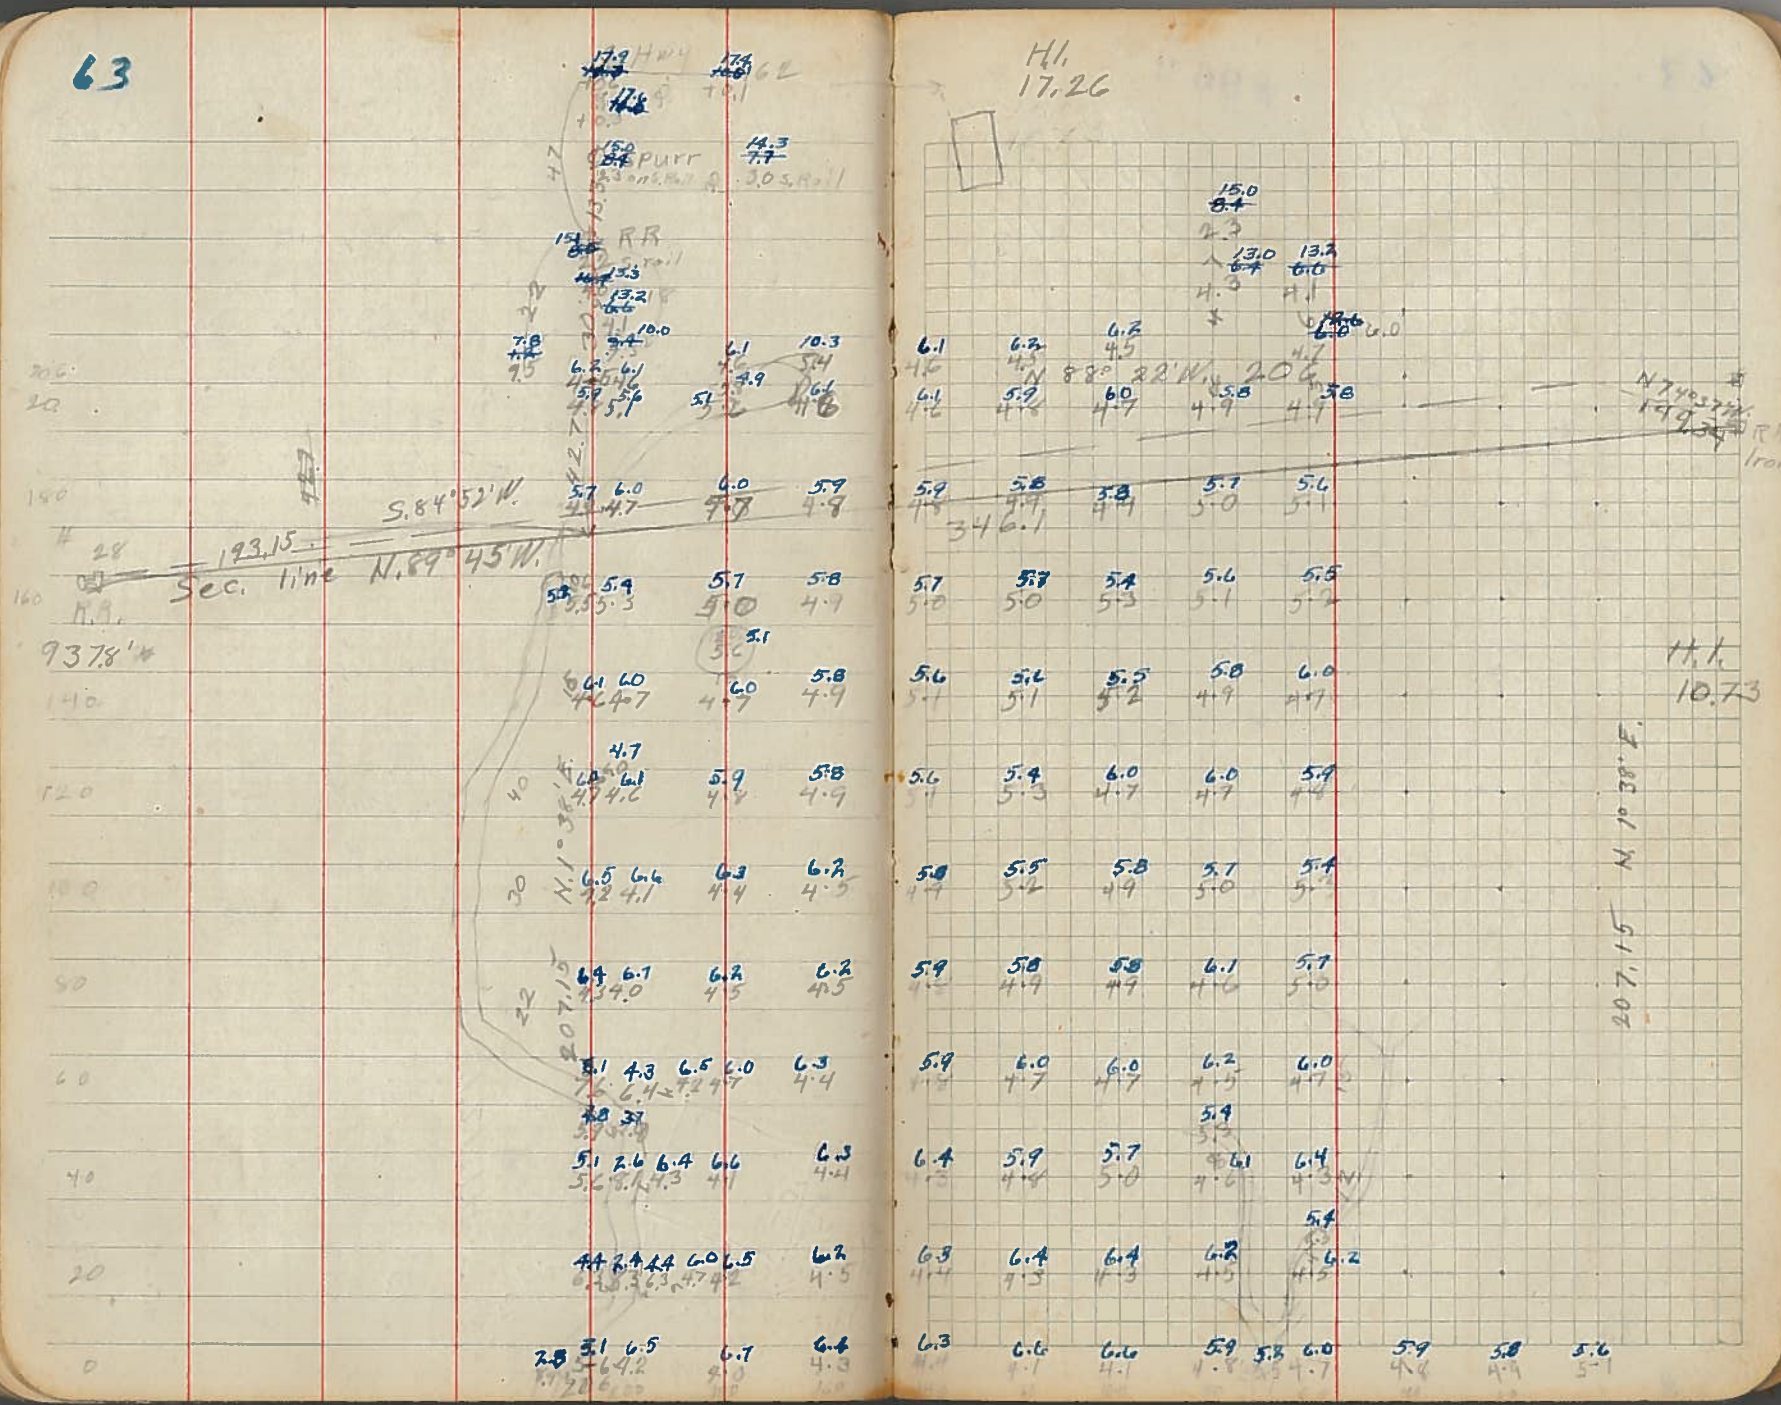
Hwy
RR
Purr
S. 84° 52' W.
193.15
Sec. line N. 89° 45' W.
N. 1° 38' E.
207.15
N 88° 22' W.
206
N 74° 37' W.
149.34
RR Iron
346.1
H.I.
17.26
H.I.
10.73
937.8'