945

BLOCK 27

Avery's 2nd ADDITION

CITY OF Corvallis. March 17 1925

39221

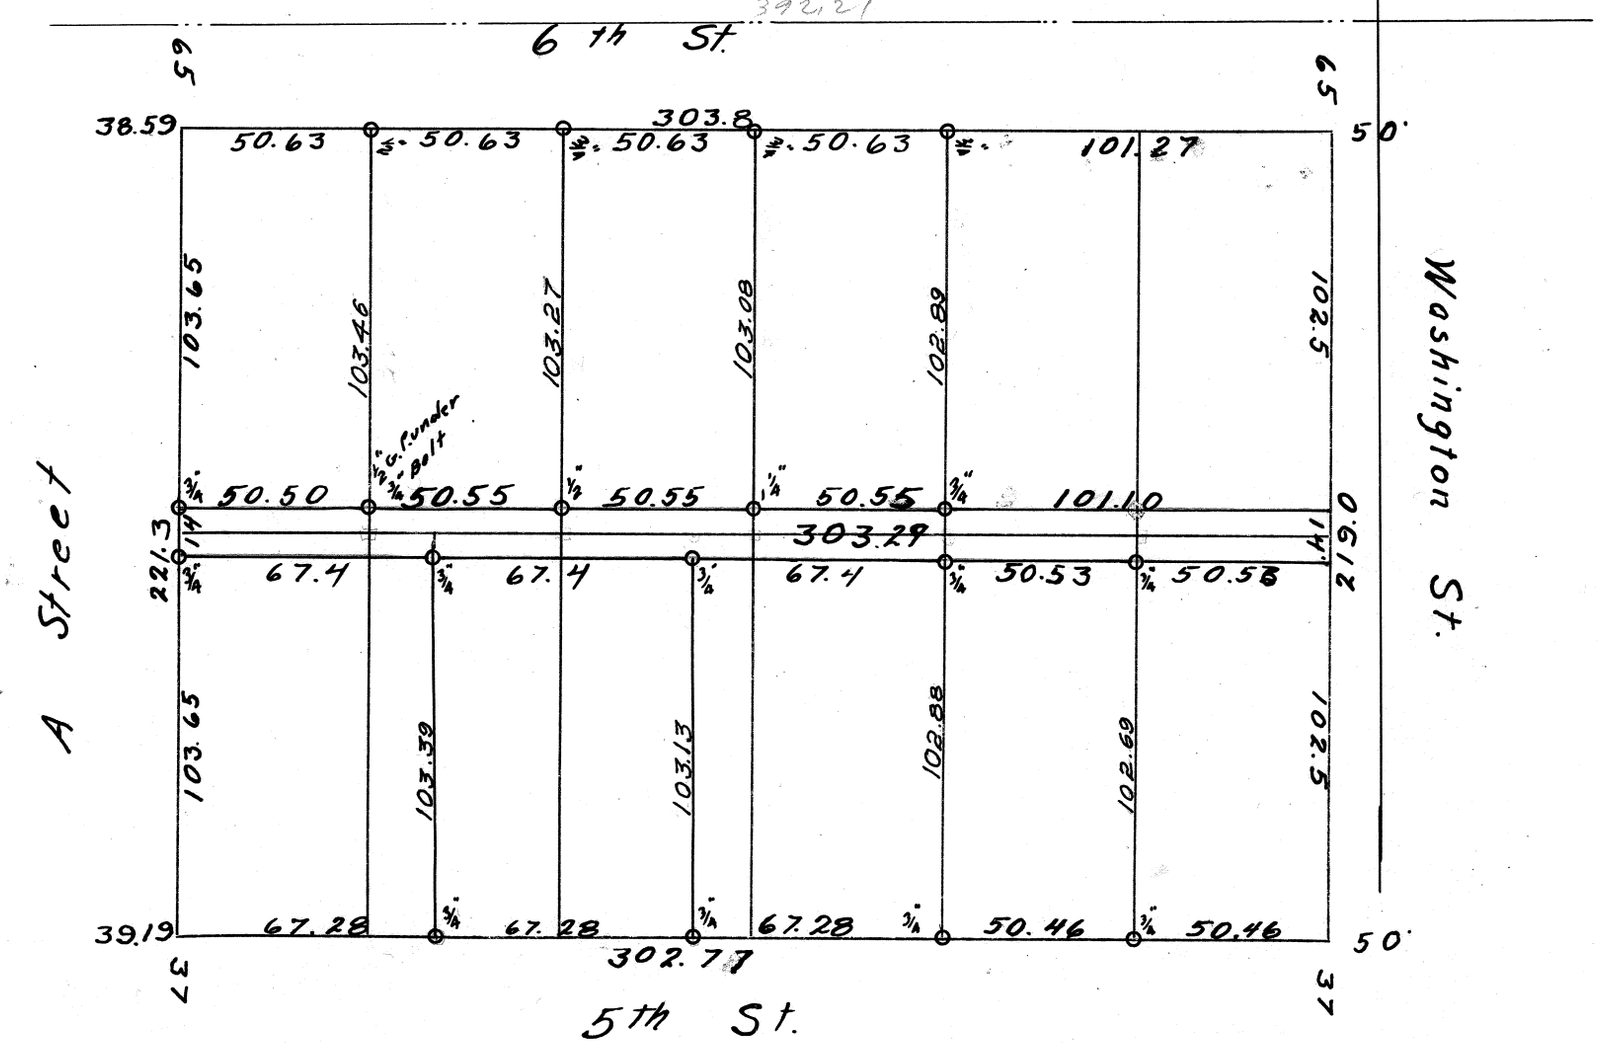

945

BLOCK 27

Avery's 2nd ADDITION

CITY OF Corvallis. March 17 1925
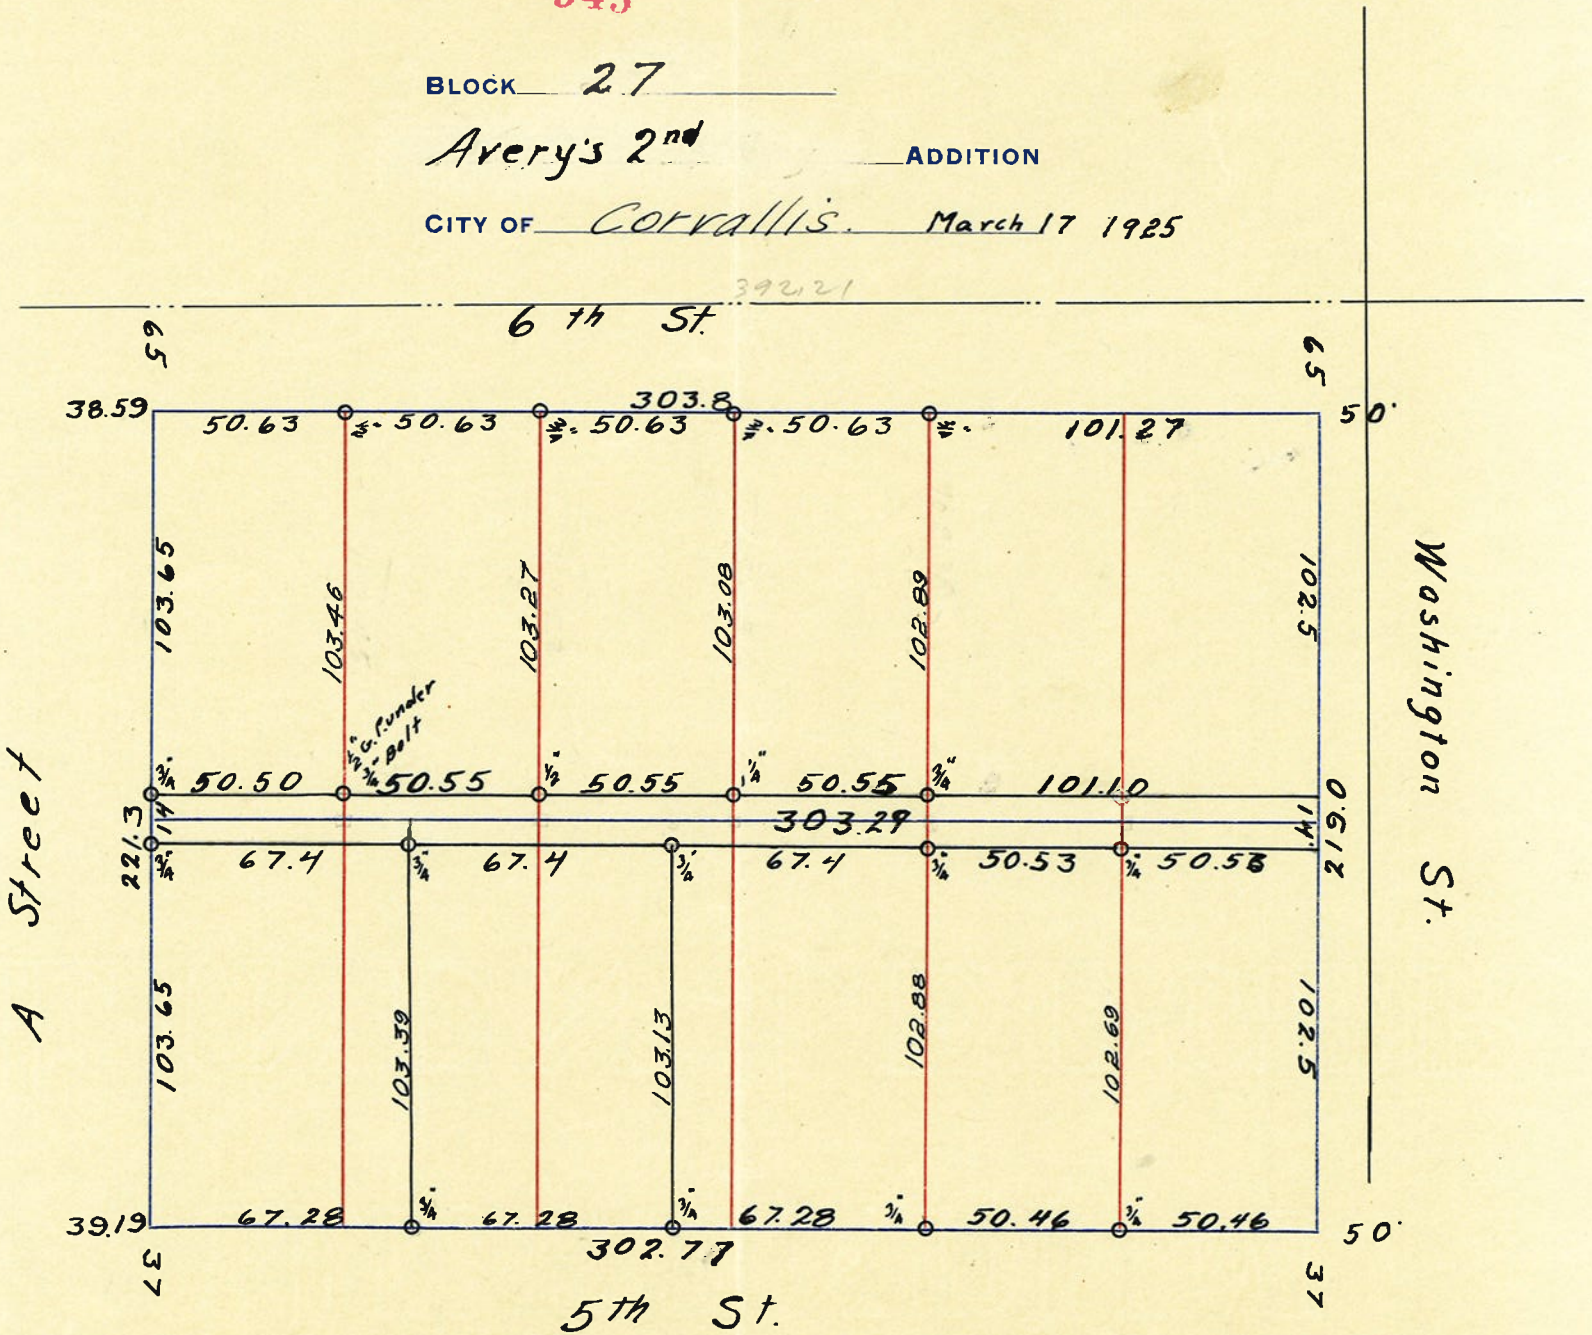
39221