C.S. 945A

RESIDENCE TELEPHONE 399-M

Block 4, Wilkins' Add.

OFFICE TELEPHONE 296-W

W. C. GALLOWAY
COUNTY SURVEYOR & ENGINEER
OF BENTON COUNTY
CORVALLIS, OREGON

May 5, 1948

Survey for David C. Fendall
by W. C. Galloway C.S.

C S 917

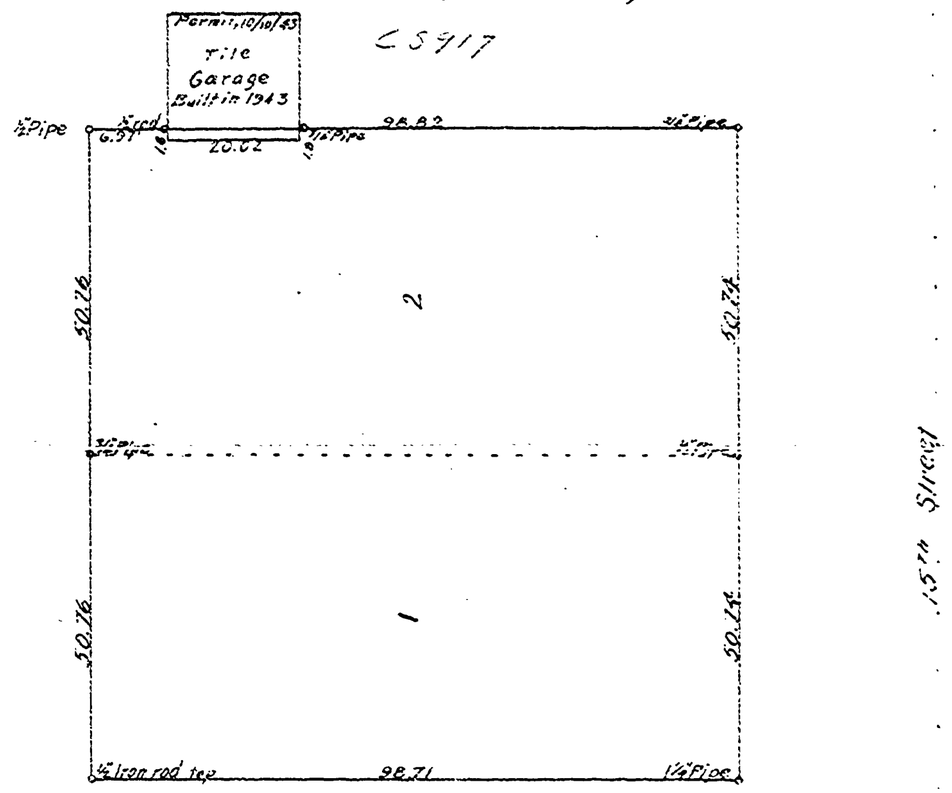

Jackson Street

W. C. Galloway