C.S. # 948

Hardcopy City Plat # 8

also see notes in file

F. B. 33-58

58

FB #33

948

ELKS Temple Voidage above walk

H.I.

5.4

5.2

Above cor. of walk at NW cor. of Tof.

224.13
1.69
225.82
214.54
11.28

224.13
.17
224.30
214.24
10.06

224.13
.3
224.43
214.24
10.19

224.43
.65
224.78 H.I.
214.24
10.54

214.24
.3
214.54

98 readings

Alley 1.69	1.5	1.3	1.5	1.2	1.1	.6	.35	.75	.7	.6	.3
	.9	1.1	1.45	1.35	1.2	.55	.7	.8	.5	.6	.27
	.8	1.1	1.45	1.4	1.2	.7	.4	.4	.47	.6	.24
	1.0	1.0	1.1	1.10	1.2	.75	.2	.22	.4	.5	.21
.89 average	1.6	1.1	1.0	.55	.9	.5	.7	.6	.3	.3	.18
	1.6	1.1	1.15	1.2	1.2	.9	.7	.5	.4	.3	.15
	1.6	1.2	1.2	1.3	1.3	.4	.65	.5	.3	.25	.12
	1.6	1.2	1.2	1.2	1.2	.5	.5	.4	.1	.6	.09
	1.6	1.6	1.0	1.4	1.0	1.0	1.2	.65	.6	.6	.05
	1.6	1.6	1.6	1.4	1.3	1.2	1.0	.7	.5	.4	.03
	1.55	1.4	1.2	1.0	.8	.6	.48	.36	.24	.12	
	Alley										

224.13 = -0.56

59

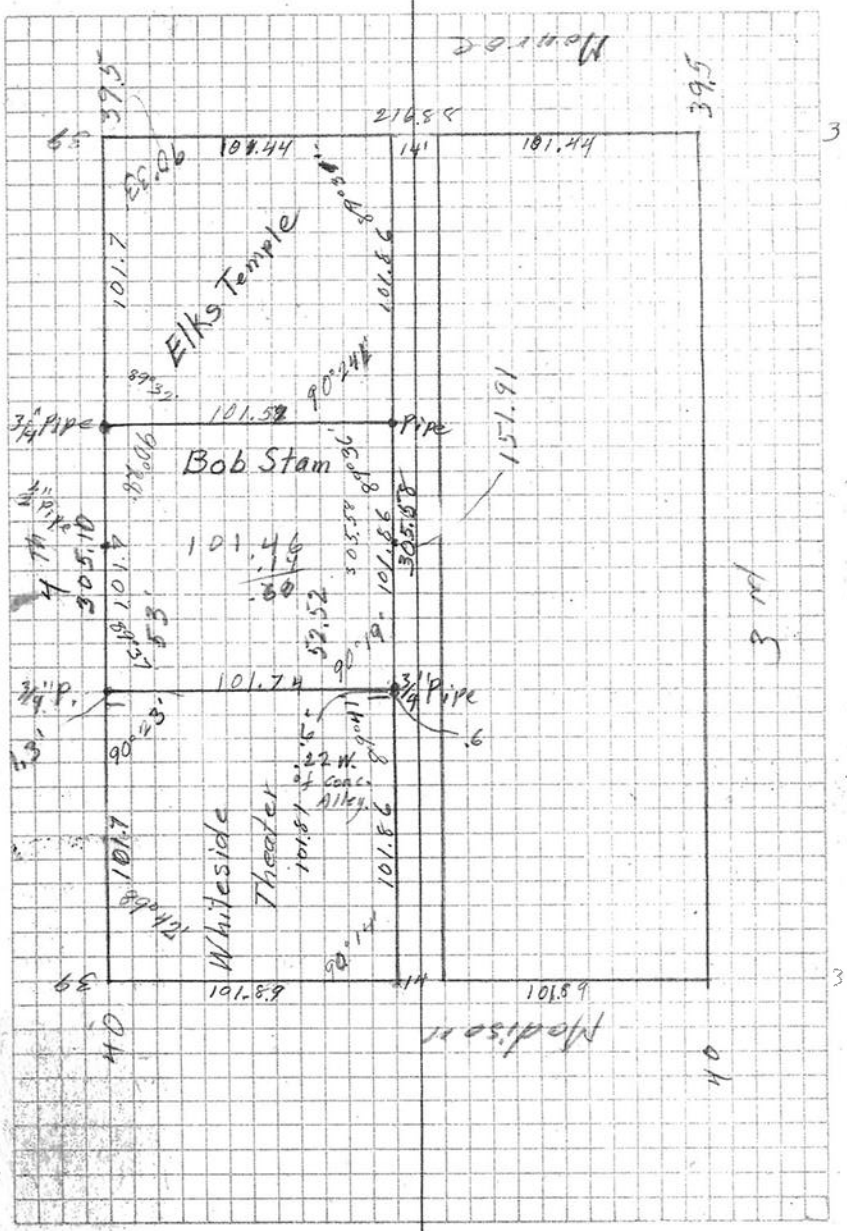
216.5'
104.44
14'
101.44
395'
37°
Elks Temple
101.7
101.56
89° 32'
90° 44'
3/4" Pipe
Pipe
101.52
Bob Stam
1.5-1.91
101.46
.14
.60
52.52
90° 19'
101.74
3/4" Pipe
.6
.22 W. of Conc. Alley
Whiteside
Theater
101.81
101.56
89° 42'
90° 14'
39'
191.89
14'
101.89
40'
37'