949 949

BLOCK 10

DIXONS 2ND ADDITION

CITY OF CORVALLIS

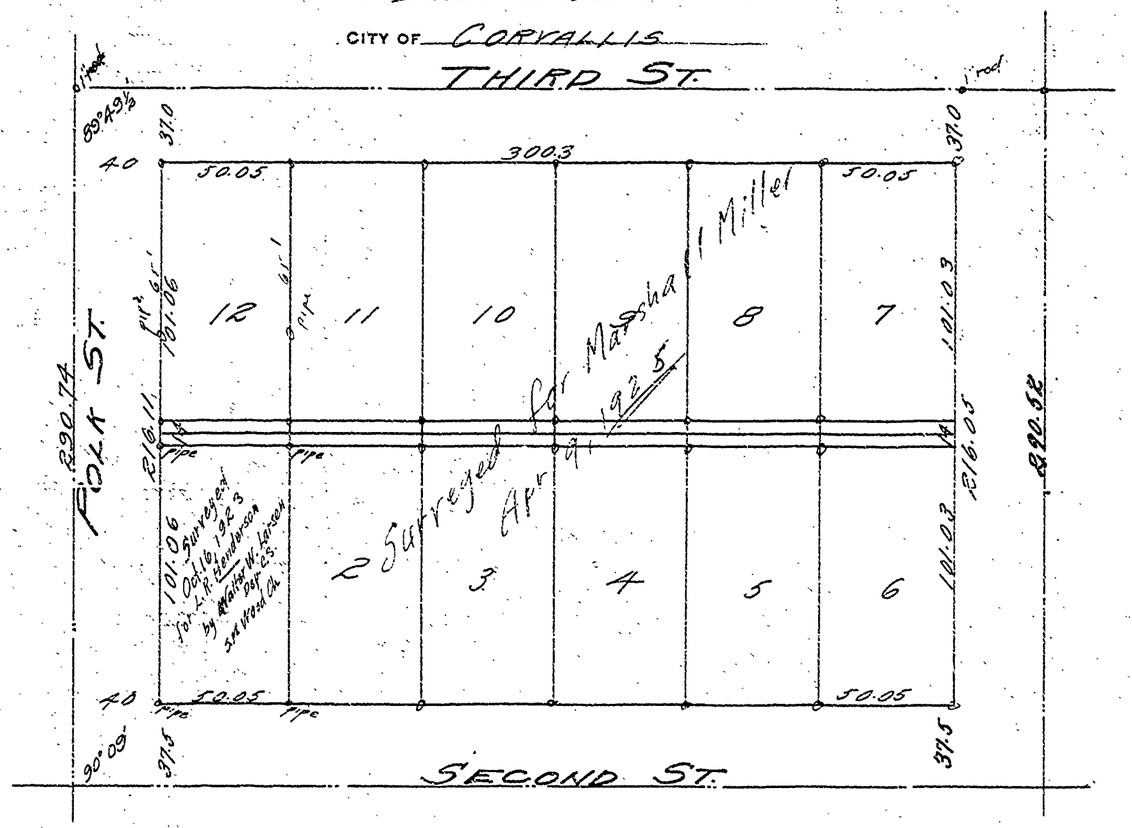

59

~~949~~ 949

BLOCK 10

DIXONS 2ND ADDITION

CITY OF CORVALLIS

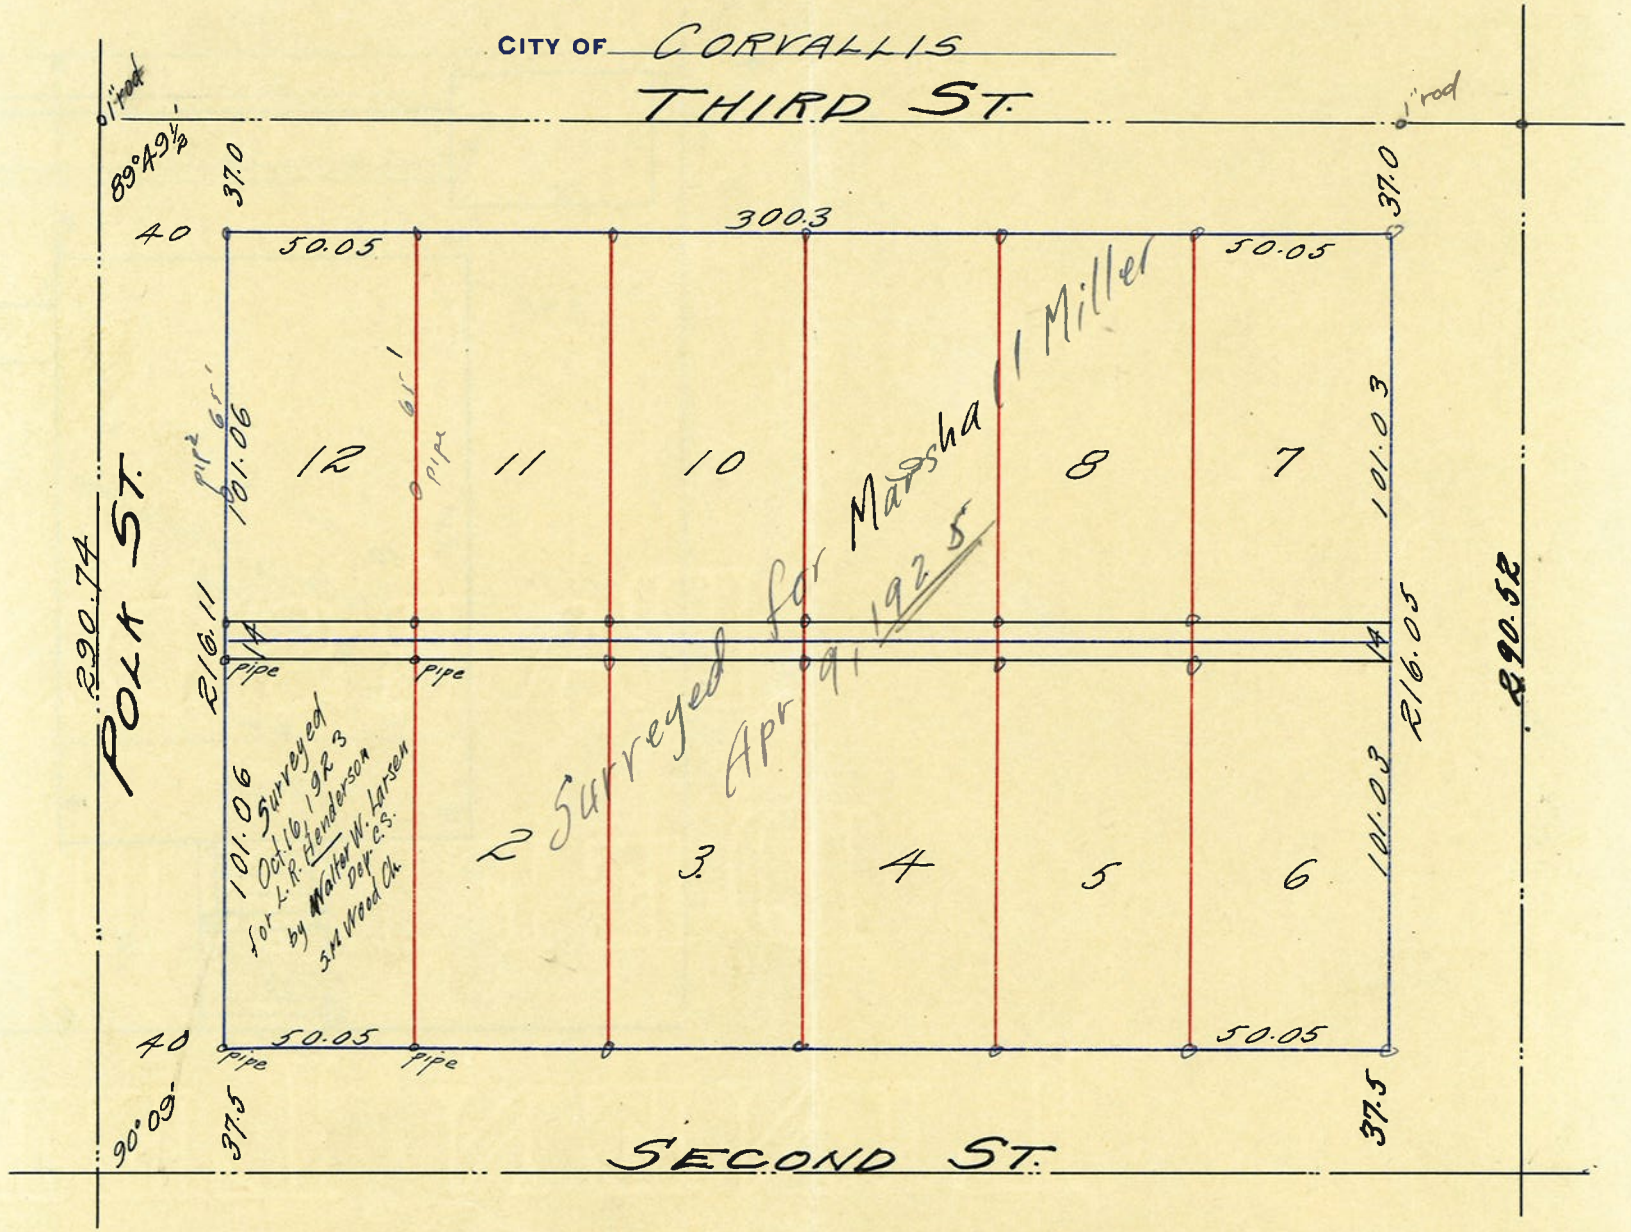

59