C.S. # 955

Hardcopy 12-6 # 23

also see notes in file

F. B. 35-11

955 CS 278 CS 955 F/B 35, P6 11-12 11

For Joe Gray

Began at a point .08 N.E. = .065 E.
of S.W. Cor. Knowlton Cl. 70 T12-6
measured from Cl. Cor.
B.S. on fence line S.W.

		52°38'L	
+4°30'			
11.550		North	
		0°56'L	
-5°			
2.294			
		1°29'R	0°33R
-2°00'			
1.598			1°59'R
-1°30'			
2.114			
			0°17'R
-16°			
3.796			
+17°45'			
.630			
			88°18'L
+12°			
3.138			
			66°35'L
+11°			
1.174			
			0°0'
+17°50'			
1.502	1.430		St. 009E
+9°			
1.310	1.300		.016E
-9°			
.972	.964		.022E
-17°32'			
3.982	3.760		.045E
-14°20'			
2.299	2.227		.058E
1.371	1.365		.066E

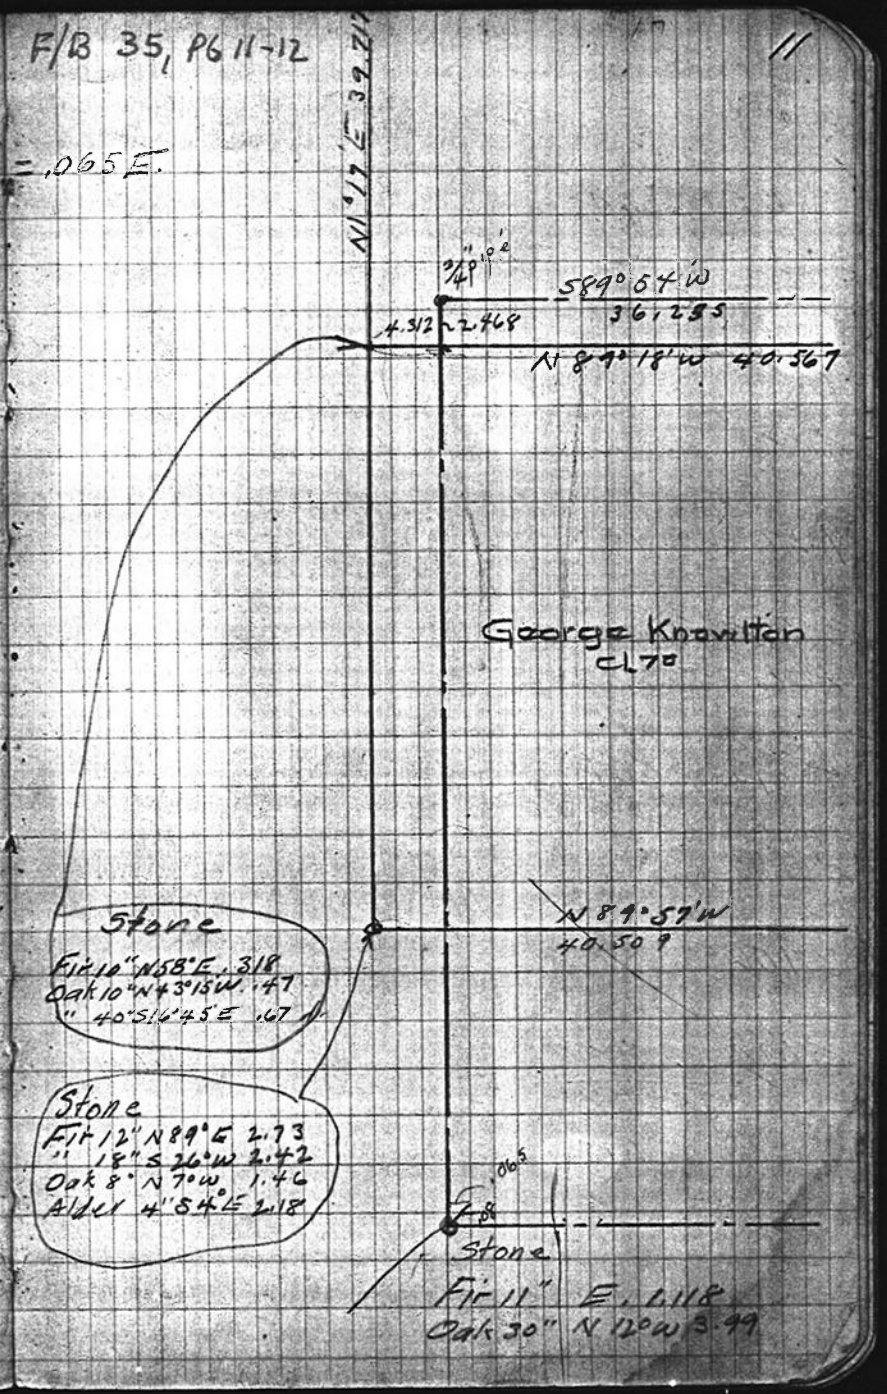

−15°					
1.805	1.744				
		0°11'R			
+16°10'					
3.054	2.933				
+10°48'					
3.162	3.107				
+28°40'					
2.885	2.532				
+11°30'					
1.203	1.179				
2.512	2.512				
2.220	2.220				
+6°30'					
4.695	4.667				
+14°					
2.345	2.275				
+12°					
3.706	3.625				
+5°50'					
2.100	2.088				
	39.718				

hit .003 W of Stone

| | | | | |