C.S. # 957

Hardcopy 11-7 #6

also see notes in file

F. B. 35-14

957 C.S. 258 FB # 35

Survey for (Devit) Shanghai Lumber Co.

Began at NW. Cor Sec 11, T11-7

South.

Run

+1.0
1.715 1.684

1.594 1.594

0°31'L

-8°20
2.32 2.295

-16°35
2.801 2.784

-15°40 +4.756
5.02 -21°0.906

4.525 4.525

+0.45
7.790 7.670

+1.0
1.783 1.770

.301 .301

2.92 2.92

8.000 8.00

1.172 1.172

Δ

8.000

0°33'R

-5°
1.964 1.956

Δ

2.25

8.00

-7°
8.00 7.940

+3.5°
1.865 1.801

+5°
1.95 1.943

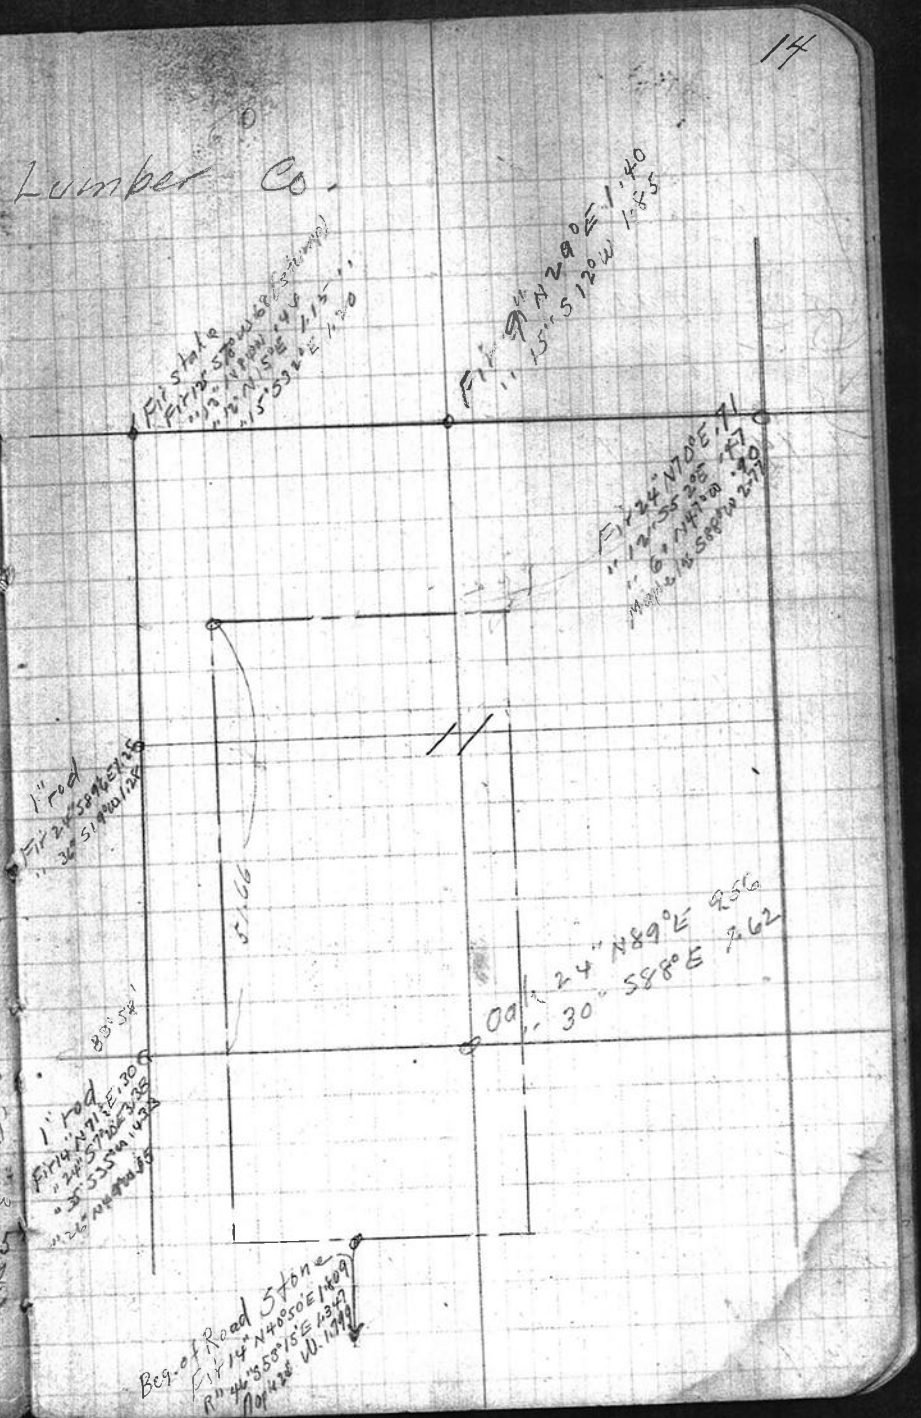

40 2.77 -.05 = 40 W. 2.76

92°32' 1.16 1/4 cor

51°29'L P.T 0+56

= 148.5'

50°55'L

1°41'L

1.746

1.449 mt 3.40W

92+04.5

-20.9

91+83.6

14

2,30 ~ 2.309
1°30'
8.00 ~ 7.970
4.88 ~ 4.836
1.995 ~ 1.947
81.220
5°25'R tot
0°48'
Back line hits 1.5' E of sta 92 RA
& hits .59 E of car
Began .02 N. of +
Run E by needle 22°
.781 .734
5.656 5.348
1.543 1.538
4.38 4.114
0°30'R
5.338 5.338 N89°38'E
Road 90°R
.319

1.16 W
.019 W
1.179 W
1.746 E
.567 E
.411 E
.978 E
.335 E
1.313 E
.184 W
1.129
40.13

1037'
1.02 81

7.940
1.801
1.943
2.30
7.970
4.836
1.938
28.728
1.419
1.956
8.000
03-1
40 1 54
28.728
11.426

.321 W
1.160
.019 W
1.500 W
1.746 E
.246 E

set .212 W
set .0147
set .426 W
731
set .1125
set .1365
set .1985
.0465
set .2335
—21 hit 3'S of Sta 132

+16°20'		90°L		
4.80	4.556			
+.063	.063		N89°08E	
+1°20'				
3.388	3.244			
-8°30'				
2.708	2.678			
		0°33'R		
-20°05'			N89°41E	
4.677	4.393			
		0°33'L		
-8°20'			N89°08E	
2.373	2.347			
△ 0°		0°38'R		
4.990	4.990		N89°46'E	
.705				
	40.048		E7°R	

156

Set fir Limb in position of Fir 8" N38°E .160 Oak sh.

Found Fir(15") 36" N15°W(1.65') 1.88

2681		89°40'R
17°50'		
2656	4.613	50°34'E
+1°25'		
4.560	4.459	
+7°20'		
2.255	2.237	
+2°28'		
3.598	3.362	
+7°5'		
1.911	1.899	

		.734
		5.348
		1.538
		4.114
		5.338
		17.072
		4.556
		.063
		3.244
		2.678
		4.393
		2.347
		4.990
		39.343
		.705
		.008
		40.056

		.046 S
		.042 S
		.056 S
		.008 S
		.319 S
		.156 S
		.627
		-020
		607

11.734
-210
11.524

40.056

.0157

.0152 0°52'

		620 N
		0925 N
		.1125
		6294 N
		.1359 N
		0623 N
		.1984 N
		0810
		.2794 N
		0465
		.2329 N
		3195
		.0865
		069 N
		.1665
		.0500 N
		.0334 N
		0404 N
		.0738 N
		0666 N
		.1404 N
		0425
		.0984 N
		0354 N
		.1338 N
		0765 N
		.2098 N
		0553
		.1538 N
		.0111 N
		.1649 N

1.890 +30' 1.396
1.424 -14° 1.396
2.750 2674 90°40'
3.680 3.670 N 89°54' W 2.34
3.639 -10° 3.579
Stone 6"X8"X18" is 1.20 N of Ch. line
Fir 14" S 14° W 40.3
" Stump 40" N 56° E .96
Run E 1.52 in line of fnc.
90° L
26.81 N 0°27'E
0°02'R. S 0°27'W
6.81
-3°
8.00

89°30' L .795 to Sta 314 PRC
105° R -16° .88 Sta 108+04 PCRR

N.E. Cor Kelley Ch
Stone 6"X10"X14"
Oak 30" S 38½° W .51
Fir 20" N 87° E .39
-15°30'
1.153 1.111 South S 0°12'E
90° R
-7°40'
8.110 8.038 West S 89°48' W
0°18' R correct 0°30' N = N 89°22' W
-11°
6.106 5.996 N 89°54' W

		0°18'L .03'N
-9°40' 8.000	7.886	589°48'W 25.898
8.000	8.000	
8.000	8.000	
+9°30' 2.04	2.012	
C Δ -4° 1.66	1.656	90°R
Δ .090		88°R
Back to hub C.		To corner
		93°04'L
+3° 4.776	4.770	
Δ hub		3°45'R to hubs.
Δ hub on -9° 8.000	7.902	⊼ line N line C.L. ± E Sec
8.000	8.000	
		90°R.
-6° 7.106	7.067	
		90°L
8.000	8.000	50°34'E
8.000	8.000	comp 0°21'E
6.785	6.785	-50°55'E
-6° 1.398	1.398	
-5°40' 2.403	2.378	

103 5

S 1.111
N .031
51.080
N 1.656
N .576
N .003
N .579
39.842

closed N 0°50' .014532

8.038
5.996
7.886
16.000
2.012
39.932
-.090
39.842

-1.20
E Road — 1.03 + .085 .15 BC Sta 111+33

Set 1" pipe - found old stump
S 46½°E 1.77.
post East .020
corner fence post East .23

or 97° 29'L to hub in field 26. E

run 5. set .18? E + 1.227 N of E hub.

1.15
16.80
7.0
8.00
8.0.0
6.78
39.93
5 1.17
11.64
3.79
7.85

7.880	7.880
~~7.106~~ +4°	
7.583	7.564

Back to point 1.52 E of stone SW corner of Hall's.

Run	S on cont. of ~~A~~ line
5.462	5.462
8.000	8.000
3.745 +5½°	3.727
1.000	1.000
5.630 −4½°	5.614
6.965 +4½°	6.944
8.060 −2½°	8.052
2.903 −5°40'	2.888

hit .170 W of cor

~~90°~~ 87°30' L to 1st cor to Col 80.187

S 0°27'W
corrd 0°17'E
= 50°10'W.

S88°04'E

.0021
.00615
.493
80.187

S88°04'E
14 2-46
230 50
N 50°50' W

88°04½
10 24 38
14 38
88 04
17 14
259 20
79 20

-4°
8.00 - 7.956 = .044
Set Oak 1.60 Stake .1956

N50°50'W
142 46 E
S14°38'W
102 42 R
N89°20'W
171 16 L

E Corn Bears 30°
Marys Peak
Oak

4.77	4.770	5.462	.170 W
6.81	36.810	8.000	.004 E
1.056	6.81	3.727	.166 W
13.236	38.39	1.000	.312 W
	41.669	5.614	.478 W
	80.040	6.944	.090 E
		8.052	.388 E .004 E-S
		2.888	= 0°17' west
		41.667 (.004)	
		−27	
		41.660	

Oak post	12"	N 28° E	.325
" "	10"	S 77° E	430
Fir	20"	S 28° W	1.390