960

BLOCK ~~24~~ 3

Orig. town ~~County~~ ADDITION
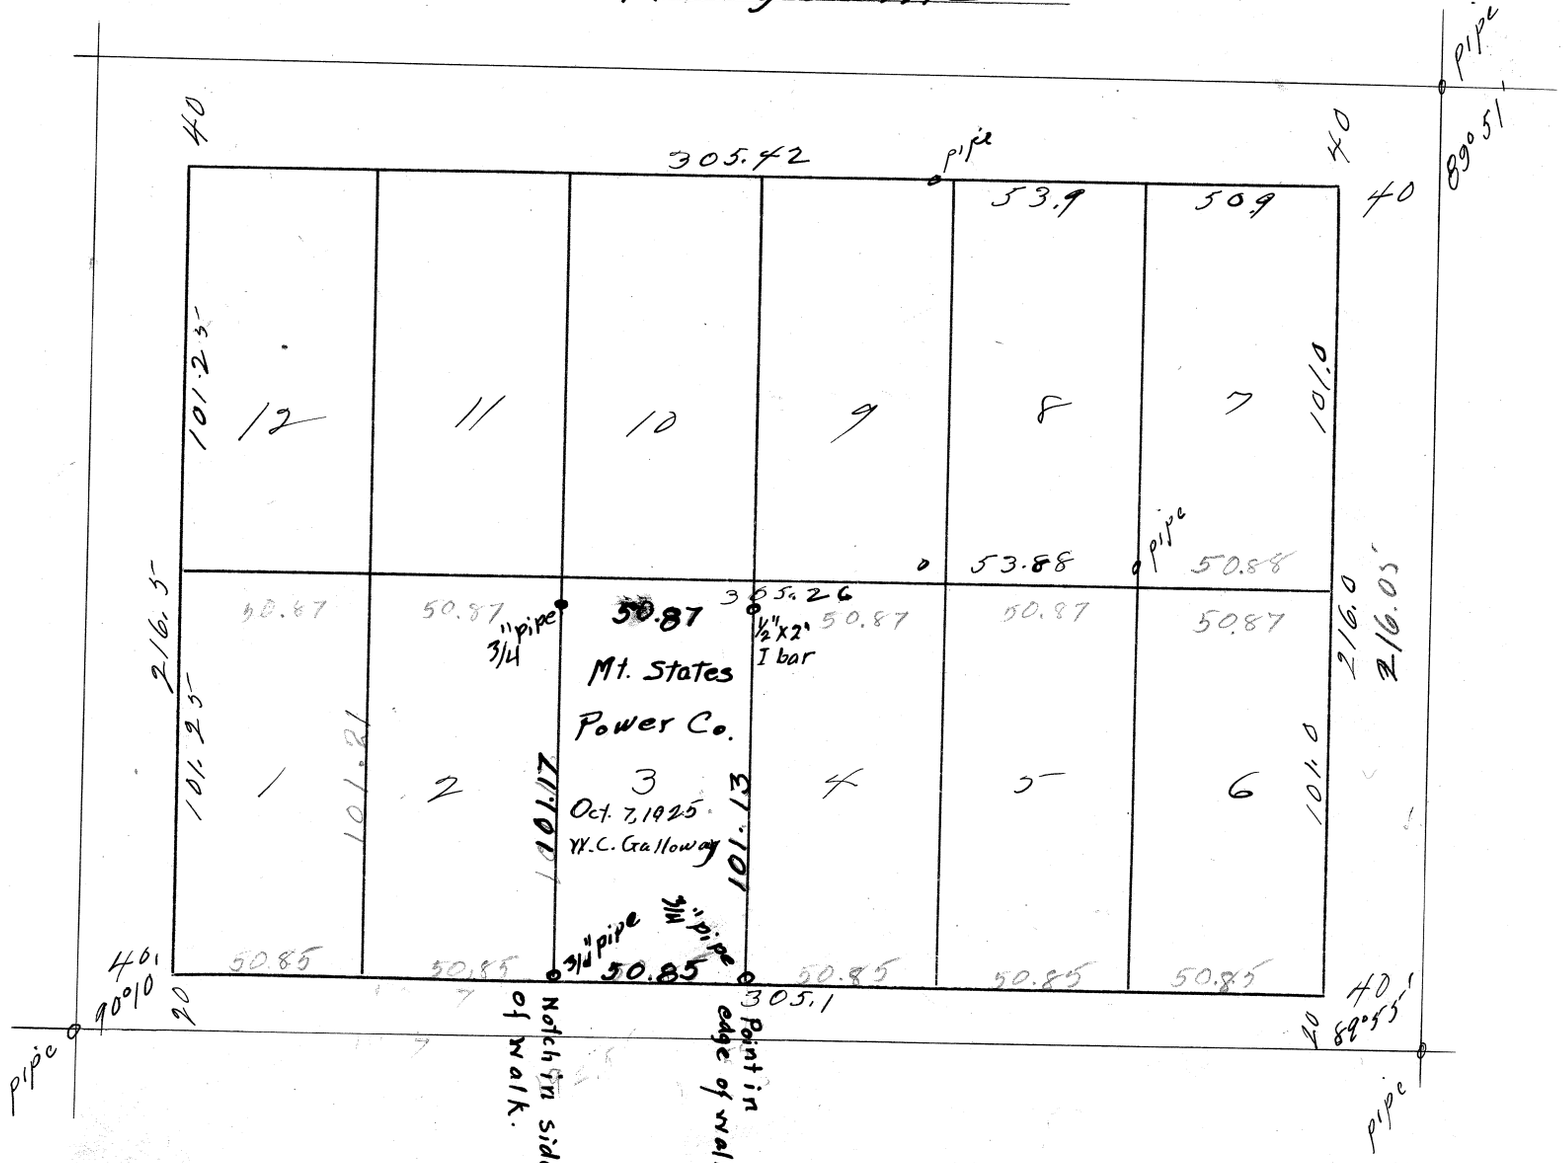
CITY OF Marysville