C.S. # 966

Hardcopy 12-5 # 32

also see notes in file

F. B. 35-34

C.S. 966 F/B 35, Pg 34

966

C.S. 75

Survey for Tom Pekit.
Butterfield Ck.
T. 12 S., R. 5 W.
Dec 15, 1925

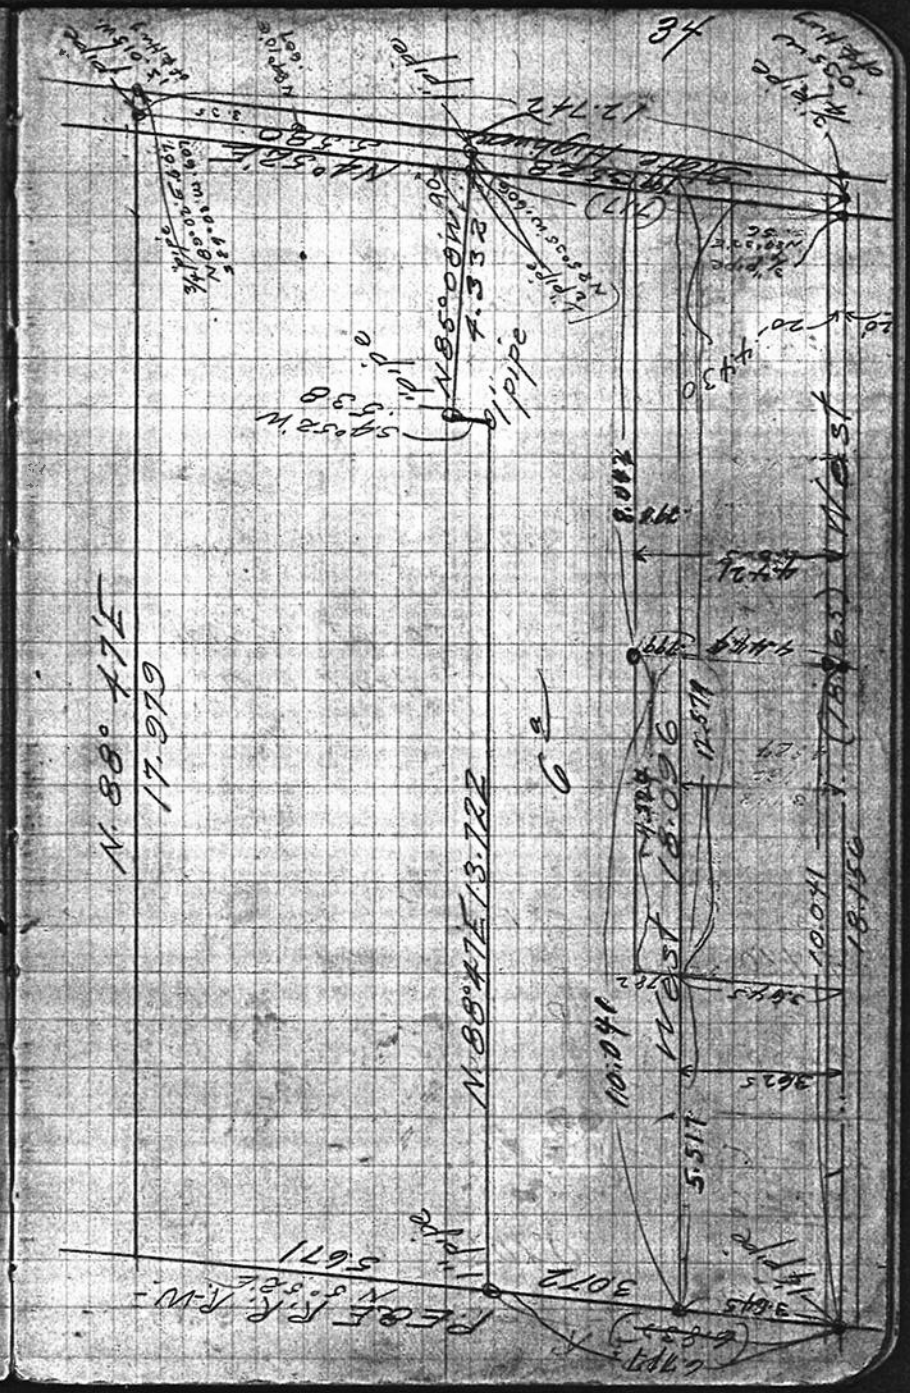
34
5671
3072
N. 88° 44' E.
